


1 LOCATE WELL: County: Stevens Fraction: SW 1/4 NE 1/4 NW 1/4 Section Number: 8 Township Number: T 33 S Range Number: R 35W E/W

Distance and direction from nearest town or city street address of well if located within city? Woods, Kansas - 2 1/2 miles West - 1 3/4 miles North into location.

2 WATER WELL OWNER: Lloyd Crawford Mobil Oil Corp./Unit 19
 RR#, St. Address, Box #: RFD 1 Board of Agriculture, Division of Water Resources
 City, State, ZIP Code: Hugoton, Kansas 67951 Application Number: T 88-494

3 LOCATE WELL'S LOCATION WITH AN "X" IN SECTION BOX:

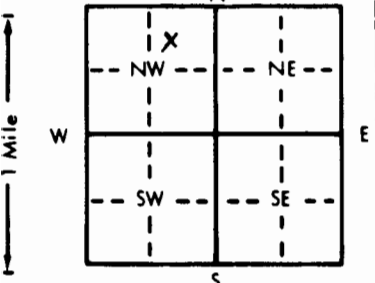

4 DEPTH OF COMPLETED WELL: 300' ft. ELEVATION:
 Depth(s) Groundwater Encountered 1. ft. 2. ft. 3. ft.
 WELL'S STATIC WATER LEVEL: 120' ft. below land surface measured on mo/day/yr 10/08/88
 Pump test data: Well water was ft. after hours pumping gpm
 Est. Yield: 100 gpm Well water was ft. after hours pumping gpm
 Bore Hole Diameter: 11" in. to 300' ft., and in. to ft.
 WELL WATER TO BE USED AS:
 1 Domestic 3 Feedlot 6 Oil field water supply 9 Dewatering 12 Other (Specify below)
 2 Irrigation 4 Industrial 7 Lawn and garden only 10 Observation well
 Was a chemical/bacteriological sample submitted to Department? Yes No X If yes, mo/day/yr sample was submitted Water Well Disinfected? Yes X No

5 TYPE OF BLANK CASING USED:
 1 Steel 3 RMP (SR) 5 Wrought iron 8 Concrete tile CASING JOINTS: Glued Clamped
 2 PVC 4 ABS 6 Asbestos-Cement 9 Other (specify below) Welded
 7 Fiberglass Threaded
 Blank casing diameter: 6.625 in. to ft., Dia in. to ft., Dia in. to ft.
 Casing height above land surface: -60" in., weight 3.71 lbs./ft. Wall thickness or gauge No. .280

TYPE OF SCREEN OR PERFORATION MATERIAL:
 1 Steel 3 Stainless steel 5 Fiberglass 8 RMP (SR) 10 Asbestos-cement
 2 Brass 4 Galvanized steel 6 Concrete tile 9 ABS 11 Other (specify)
 12 None used (open hole)

SCREEN OR PERFORATION OPENINGS ARE:
 1 Continuous slot 3 Mill slot 5 Gauzed wrapped 8 Saw cut 11 None (open hole)
 2 Louvered shutter 4 Key punched 6 Wire wrapped 9 Drilled holes
 7 Torch cut 10 Other (specify)

SCREEN-PERFORATED INTERVALS: From ft. to ft. From ft. to ft. From ft. to ft.
 GRAVEL PACK INTERVALS: From 27' ft. to 80' ft. From 90' ft. to 300' ft.

6 GROUT MATERIAL: 1 Neat cement 2 Cement grout 3 Bentonite 4 Other
 Grout Intervals: From 5' ft. to 27' ft. From 80' ft. to 90' ft. From ft. to ft.

What is the nearest source of possible contamination:
 1 Septic tank 4 Lateral lines 7 Pit privy 10 Livestock pens 14 Abandoned water well
 2 Sewer lines 5 Cess pool 8 Sewage lagoon 11 Fuel storage 15 Oil well/Gas well
 3 Watertight sewer lines 6 Seepage pit 9 Feedyard 12 Fertilizer storage 16 Other (specify below)
 13 Insecticide storage
 Direction from well? Southeast How many feet? 170'

FROM	TO	LITHOLOGIC LOG	FROM	TO	LITHOLOGIC LOG
0'	5	dirt .98 cu. feet of dirt			
5	7	cement .39 cu. feet of cement			
7	27	bentonite grout 3.93 cu. feet of bentonite grout			
27	80	chlorinated gravel 10.40 cu. feet of chlorinated gravel			
80	90	bentonite grout 1.96 cu. feet of bentonite grout			
90	300	chlorinated gravel 41.22 cu. feet of chlorinated gravel			

7 CONTRACTOR'S OR LANDOWNER'S CERTIFICATION: This water well was (1) constructed, (2) reconstructed, or (3) plugged under my jurisdiction and was completed on (mo/day/year) 12/01/88 and this record is true to the best of my knowledge and belief. Kansas Water Well Contractor's License No. 118 This Water Well Record was completed on (mo/day/yr) 12/05/88 under the business name of Carlile Water Well Service, Inc. by signature