


1 LOCATION OF WATER WELL: Fraction SW 1/4 SE 1/4 SE 1/4 Section Number 12 Township Number T 33 S Range Number R 35 E/W

Distance and direction from nearest town or city street address of well if located within city?
 2 East and 1 North of Woods, Kansas

2 WATER WELL OWNER: CHESTER CLINE Board of Agriculture, Division of Water Resources
 RR#, St. Address, Box #: RFD #1 Application Number: ----
 City, State, ZIP Code: Hugoton, Kansas 67951

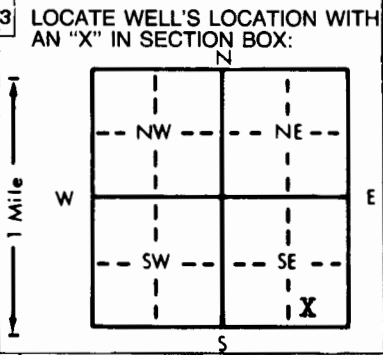

4 DEPTH OF COMPLETED WELL: 248 ft. ELEVATION: Slope
 Depth(s) Groundwater Encountered 1. Not available ft. 2. ft. 3. ft.
 WELL'S STATIC WATER LEVEL . . . 155 . . . ft. below land surface measured on mo/day/yr October 21, 1985
 Pump test data: Well water was ft. after hours pumping gpm
 Est. Yield . . 30 . . . gpm: Well water was ft. after hours pumping gpm
 Bore Hole Diameter . . . 9 7/8 in. to . 248 . . . ft., and in. to ft.
 WELL WATER TO BE USED AS: 5 Public water supply 8 Air conditioning 11 Injection well
 XXX Domestic 3 Feedlot 6 Oil field water supply 9 Dewatering 12 Other (Specify below)
 2 Irrigation 4 Industrial 7 Lawn and garden only 10 Observation well
 Was a chemical/bacteriological sample submitted to Department? Yes No XX; If yes, mo/day/yr sample was submitted
 Water Well Disinfected? Yes XX No

5 TYPE OF BLANK CASING USED: 5 Wrought iron 8 Concrete tile CASING JOINTS: Glued XX Clamped
 1 Steel 3 RMP (SR) 6 Asbestos-Cement 9 Other (specify below) Welded
 XX PVC 4 ABS 7 Fiberglass Threaded
 Blank casing diameter . . . 5 . . . in. to . 218 . . . ft., Dia in. to ft., Dia in. to ft.
 Casing height above land surface 15 in., weight . . . 2.8 lbs./ft. Wall thickness or gauge No. . . . 265
 TYPE OF SCREEN OR PERFORATION MATERIAL: XX PVC 10 Asbestos-cement
 1 Steel 3 Stainless steel 5 Fiberglass 8 RMP (SR) 11 Other (specify)
 2 Brass 4 Galvanized steel 6 Concrete tile 9 ABS 12 None used (open hole)
 SCREEN OR PERFORATION OPENINGS ARE: 5 Gauzed wrapped XX Saw cut 11 None (open hole)
 1 Continuous slot 3 Mill slot 6 Wire wrapped 9 Drilled holes
 2 Louvered shutter 4 Key punched 7 Torch cut 10 Other (specify)
 SCREEN-PERFORATED INTERVALS: From . . . 218 . . . ft. to . . . 248 . . . ft., From ft. to ft.
 From ft. to ft., From ft. to ft.
 GRAVEL PACK INTERVALS: From . . . 14 . . . ft. to . . . 248 . . . ft., From ft. to ft.
 From ft. to ft., From ft. to ft.

6 GROUT MATERIAL: XX Neat cement 2 Cement grout 3 Bentonite 4 Other
 Grout Intervals: From . . . 4 . . . ft. to . . . 14 . . . ft., From ft. to ft., From ft. to ft.
 What is the nearest source of possible contamination:
 XX Septic tank 4 Lateral lines 7 Pit privy 10 Livestock pens 14 Abandoned water well
 2 Sewer lines 5 Cess pool 8 Sewage lagoon 11 Fuel storage 15 Oil well/Gas well
 3 Watertight sewer lines 6 Seepage pit 9 Feedyard 12 Fertilizer storage 16 Other (specify below)
 13 Insecticide storage
 Direction from well? East 100 feet How many feet? 100

| FROM | TO | LITHOLOGIC LOG | FROM | TO | LITHOLOGIC LOG |
|------|-----|----------------------------|------|----|----------------|
| 0 | 2 | Topsoil | | | |
| 2 | 60 | Fine Sand | | | |
| 60 | 160 | Clay | | | |
| 160 | 195 | Med. to Fine Sand | | | |
| 195 | 200 | Rock & Clay | | | |
| 200 | 236 | Med. Sand | | | |
| 236 | 290 | Clay, Very Soft and Sticky | | | |
| 290 | 300 | Very Fine Sand | | | |

7 CONTRACTOR'S OR LANDOWNER'S CERTIFICATION: This water well was (1) constructed, (2) reconstructed, or (3) plugged under my jurisdiction and was completed on (mo/day/year) . . November 1, 1985 and this record is true to the best of my knowledge and belief. Kansas Water Well Contractor's License No. . . . 252 This Water Well Record was completed on (mo/day/yr) . . November 4, 1985 under the business name of FRIESEN WINDMILL & SUPPLY INC. by (signature)

INSTRUCTIONS: Use typewriter or ball point pen, PLEASE PRESS FIRMLY and PRINT clearly. Please fill in blanks, underline or circle the correct answers. Send top three copies to Kansas Department of Health and Environment, Division of Environment, Environmental Geology Section, Topeka, KS 66620. Send one to WATER WELL OWNER and retain one for your records.

800000000-90

OFFICE USE ONLY

T

R

EW

SEC.

1/4

1/4

1/4