


1 LOCATION OF WATER WELL: Fraction 1/4 C-SW 1/4 NW 1/4 Section Number 13 Township Number T 33 S Range Number R 35 E44  
 County: Stevens

Distance and direction from nearest town or city street address of well if located within city? From Woods go 1mi East 1/2mi North east side of road.

2 WATER WELL OWNER: Burgis Campbell  
 RR#, St. Address, Box # : Route #1 Box 33 Board of Agriculture, Division of Water Resources  
 City, State, ZIP Code : Hugoton, Kansas 67951 Application Number:

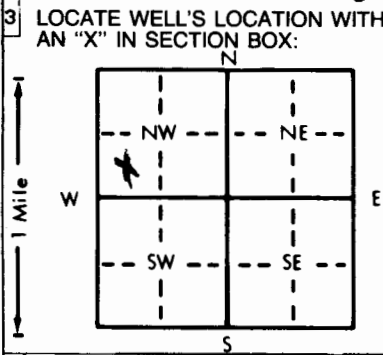

4 DEPTH OF COMPLETED WELL 407 ft. ELEVATION: .....  
 Depth(s) Groundwater Encountered 1. 234 ft. 2. .... ft. 3. .... ft.  
 WELL'S STATIC WATER LEVEL 173 ft. below land surface measured on mo/day/yr 7/30/85  
 Pump test data: Well water was ..... ft. after ..... hours pumping ..... gpm  
 Est. Yield 50 gpm: Well water was ..... ft. after ..... hours pumping ..... gpm  
 Bore Hole Diameter 9 in. to 407 ft., and ..... in. to ..... ft.  
 WELL WATER TO BE USED AS: 5 Public water supply 8 Air conditioning 11 Injection well  
1 Domestic 3 Feedlot 6 Oil field water supply 9 Dewatering 12 Other (Specify below)  
 2 Irrigation 4 Industrial 7 Lawn and garden only 10 Observation well  
 Was a chemical/bacteriological sample submitted to Department? Yes.....No.....; If yes, mo/day/yr sample was submitted  
 Water Well Disinfected? Yes No

5 TYPE OF BLANK CASING USED: 5 Wrought iron 8 Concrete tile CASING JOINTS: Glued Clamped .....  
 1 Steel 3 RMP (SR) 6 Asbestos-Cement 9 Other (specify below) Welded .....  
 2 PVC 4 ABS 7 Fiberglass Threaded.....  
 Blank casing diameter 5 in. to 320 ft., Dia ..... in. to ..... ft., Dia ..... in. to ..... ft.  
 Casing height above land surface 28 in., weight 2.78 lbs./ft. Wall thickness or gauge No. .255  
 TYPE OF SCREEN OR PERFORATION MATERIAL: 7 PVC 10 Asbestos-cement  
 1 Steel 3 Stainless steel 5 Fiberglass 8 RMP (SR) 11 Other (specify) .....  
 2 Brass 4 Galvanized steel 6 Concrete tile 9 ABS 12 None used (open hole)  
 SCREEN OR PERFORATION OPENINGS ARE: 5 Gauzed wrapped 8 Saw cut 11 None (open hole)  
 1 Continuous slot 3 Mill slot 6 Wire wrapped 9 Drilled holes  
 2 Louvered shutter 4 Key punched 7 Torch cut 10 Other (specify) .....  
 SCREEN-PERFORATED INTERVALS: From 260 ft. to 280 ft., From ..... ft. to ..... ft.  
 From 340 ft. to 407 ft., From ..... ft. to ..... ft.  
 GRAVEL PACK INTERVALS: From 15 ft. to 407 ft., From ..... ft. to ..... ft.  
 From ..... ft. to ..... ft., From ..... ft. to ..... ft.

6 GROUT MATERIAL: 1 Neat cement 2 Cement grout 3 Bentonite 4 Other .....  
 Grout Intervals: From 5 ft. to 15 ft., From ..... ft. to ..... ft., From ..... ft. to ..... ft.  
 What is the nearest source of possible contamination:  
 1 Septic tank 4 Lateral lines 7 Pit privy 10 Livestock pens 14 Abandoned water well  
 2 Sewer lines 5 Cess pool 8 Sewage lagoon 11 Fuel storage 15 Oil well/Gas well  
 3 Watertight sewer lines 6 Seepage pit 9 Feedyard 12 Fertilizer storage 16 Other (specify below)  
 13 Insecticide storage .....  
 Direction from well? West How many feet? 200'

| FROM | TO  | LITHOLOGIC LOG                    | FROM | TO | LITHOLOGIC LOG |
|------|-----|-----------------------------------|------|----|----------------|
| 0    | 2   | surface                           |      |    |                |
| 2    | 13  | clay                              |      |    |                |
| 13   | 27  | med. to large sand                |      |    |                |
| 27   | 143 | clay                              |      |    |                |
| 143  | 187 | med. to large sand                |      |    |                |
| 187  | 238 | 30% clay & 70% med. to large sand |      |    |                |
| 238  | 261 | sandy clay                        |      |    |                |
| 261  | 292 | fine sand                         |      |    |                |
| 292  | 307 | false red bed                     |      |    |                |
| 307  | 401 | clay                              |      |    |                |

7 CONTRACTOR'S OR LANDOWNER'S CERTIFICATION: This water well was (1) constructed, (2) reconstructed, or (3) plugged under my jurisdiction and was completed on (mo/day/year) July 30, 1985 and this record is true to the best of my knowledge and belief. Kansas Water Well Contractor's License No. 118 This Water Well Record was completed on (mo/day/yr) August 8, 1985 under the business name of Carlile Water Well Service, Inc. by (signature) [Signature]

INSTRUCTIONS: Use typewriter or ball point pen, PLEASE PRESS FIRMLY and PRINT clearly. Please fill in blanks, underline or circle the correct answers. Send top three copies to Kansas Department of Health and Environment, Division of Environment, Environmental Geology Section, Topeka, KS 66620. Send one to WATER WELL OWNER and retain one for your records.

OFFICE USE ONLY

T

R

EW

SEC.

1/4

1/4

1/4