USE TYPEWRITER OR BALL POINT PEN-PRESS FIRMLY, PRINT CLEARLY.

WATER WELL RECORD
KSA 82a-1201-1215

Kansas Department of Health and Environment-Division of Environment
(Water well Contractors)
Topeka, Kansas 66620

1. Location of well:	County	Fraction	Section number	Township number	Range number
	Stevens	NW 1/4 SW 1/4 SW 1/4	14	T 33 S	R 35 E/W

2. Distance and direction from nearest town or city: 13 Miles E. of Hugoton K.
Street address of well location if in city: Woods, K.

3. Owner of well: Alvin Gaskill
R.R. or street:
City, state, zip code: Moscow Kansas 67952

4. Locate with "X" in section below:

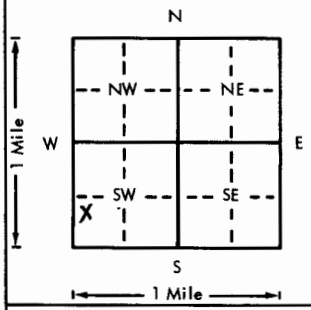

Sketch map:

6. Bore hole dia. 10 in. Completion date 12-22-75
Well depth 380 ft.

7. __ Cable tool X Rotary __ Driven __ Dug
__ Hollow rod __ Jetted __ Bored __ Reverse rotary

8. Use: X Domestic __ Public supply __ Industry
__ Irrigation __ Air conditioning __ Stock
__ Lawn __ Oil field water __ Other

9. Casing: Material _____ Height: Above or below
Threaded ____ Welded ____ Surface 12 in.
RMP ____ PVC SCH40 Weight 2.75 lbs./ft.
Dia. 5 in. to 380 ft. depth Wall Thickness: inches or
Dia. ____ in. to ____ ft. depth gage No. 250

10. Screen: Manufacturer's name _____
Type Saw Cut Dia. 5"
Slot/gauze 1/8 Length 20'
Set between 360 ft. and 380 ft.
____ ft. and ____ ft.
Gravel pack? X Size range of material 1/16 - 1/4

11. Static water level: mo./day/yr.
105 ft. below land surface Date 12-22-75

12. Pumping level below land surfaces:
110 ft. after 6 hrs. pumping 17 g.p.m.
____ ft. after ____ hrs. pumping ____ g.p.m.
Estimated maximum yield 3 Gal-Per-Foot g.p.m.

13. Water sample submitted: mo./day/yr.
__ Yes X No Date _____

14. Well head completion:
X Pitless adapter 12 Inches above grade

15. Well grouted? X
With: __ Neat cement __ Bentonite X Concrete
Depth: From 3 ft. to 13 ft.

16. Nearest source of possible contamination:
ft. 50 Direction W Type Septic
Well disinfected upon completion? X Yes __ No

17. Pump: Reda __ Not installed
Manufacturer's name _____
Model number 1709P HP 1 Volts 230
Length of drop pipe 180 ft. capacity 17 g.p.m.
Type:
X Submersible __ Turbine
__ Jet __ Reciprocating
__ Centrifugal __ Other

5. Type and color of material

Type and color of material	From	To
Top soil dark	0	6
redish sand	6	40
Sand corse + fine Mixed	40	90
Clay shelf	90	94
Sand corse + fine Gravels	94	97
Clay shelf + joint clays	97	100
sand calcified	100	112
clay shelf	112	117
Sand fine + joint clays	117	180
joint clays + sand - brown - loose	180	240
Clays liney	240	220
" balls w/sand to sand w/clay balls	220	236
clays silty	236	300
" balls + sand-corse + fine Grave	300	360
fine Grave + corse sand	360	380

(Use a second sheet if needed)

18. Elevation:
Topography:
__ Hill
__ Slope
X Upland
__ Valley

19. Remarks:

20. Water well contractor's certification:
This well was drilled under my jurisdiction and this report is true to the best of my knowledge and belief.
Slocum Drilling 127
Business name License No.
Address Box 237 Hugoton K.
Signed Paul Slocum Date 1-9-76
Authorized representative

T 33 S R 35 E Sec 14 NW SW SW 1/4 1/4 1/4 1/4

Forward the white, blue and pink copies to the Department of Health and Environment

Form WWC-5