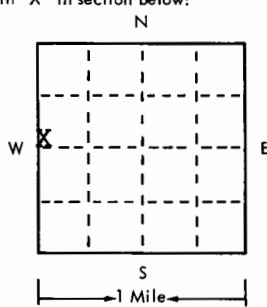


USE TYPEWRITER OR BALL POINT PEN-PRESS FIRMLY, PRINT CLEARLY.

WATER WELL RECORD  
KSA 82a-1201-1215

Kansas State Dept. Of Health  
(Water Well Contractors)  
Forbes-Bldg. 740  
Topeka, Kansas 66620

1 Location of well:	County <b>Stevens</b>	Township name	Fraction <b>SW, SW, NW</b>	Section number <b>31</b>	Town number <b>33S</b>	Range number <b>35W</b>				
Distance and direction from nearest town or city: <b>Approx. 9 Miles E &amp; 2 1/2 Mi. south of Hugoton</b> Street address of well location if in city:				3 Owner of well: <b>Paul Nix R.R. Hugoton, Kansas</b> Address:						
Locate with "X" in section below:  Sketch map:				4 Well depth: <b>460</b> ft. Date of completion <b>3/19/75</b> Well diameter <b>28</b> in.						
2 Type and color of material				5 <input type="checkbox"/> Cable tool <input type="checkbox"/> Rotary <input type="checkbox"/> Driven <input type="checkbox"/> Dug <input type="checkbox"/> Hollow rod <input type="checkbox"/> Jetted <input type="checkbox"/> Bored <input checked="" type="checkbox"/> Reverse rotary						
				6 Use: <input type="checkbox"/> Domestic <input type="checkbox"/> Public supply <input type="checkbox"/> Industry <input checked="" type="checkbox"/> Irrigation <input type="checkbox"/> Air conditioning <input type="checkbox"/> Commercial <input type="checkbox"/> Test well						
				7 Casing: Material <b>Stl</b> Height: <u>above/below</u> Threaded <input type="checkbox"/> Welded <input checked="" type="checkbox"/> Surface <b>12</b> in. Diam. Weight <b>37</b> lbs./ft. <b>16</b> in. to <b>460</b> depth Drive shoe? <input type="checkbox"/> Yes <input checked="" type="checkbox"/> No in. to ft. depth						
Well drilled near TH 3-74 (see attached), which is located at the SW corner of the NW 1/4, Sec. 31, T37S, T35W, Stevens County, Ks.				8 Screen: Manufacturer <b>Brown &amp; Foster</b> Type <b>Louver &amp; Millslot</b> Dia. <b>16"</b> Slot/gauze <b>1/8"</b> Length <b>155'</b> Set between <b>305</b> ft. and <b>460</b> ft. Fittings: <b>1-9 MM</b> Gravel pack <input checked="" type="checkbox"/> Yes <input type="checkbox"/> No Size range of material						
				9 Static water level: <b>143</b> ft. below land surface Date <b>2-4-75</b>						
				10 Pumping level below land surfaces: <b>19</b> ft. after <b>1/2</b> hrs. pumping <b>1100</b> g.p.m. <b>249</b> ft. after <b>1</b> hrs. pumping <b>2245</b> g.p.m. Estimated maximum yield <b>2300</b> g.p.m.						
				11 Water sample submitted: <input type="checkbox"/> Yes <input checked="" type="checkbox"/> No Date						
				12 Well head completion: <input type="checkbox"/> Pitless adapter <input checked="" type="checkbox"/> Inches above grade						
				13 Well grouted? <input checked="" type="checkbox"/> Yes <input type="checkbox"/> No <input type="checkbox"/> Neat cement <input checked="" type="checkbox"/> Bentonite Depth: From <b>0</b> ft. to <b>10</b> ft.						
				14 Nearest source of possible contamination: <b>unk</b> ft. Direction Type Well disinfected upon completion? <input checked="" type="checkbox"/> Yes <input type="checkbox"/> No						
				15 Pump: <input type="checkbox"/> Not installed Manufacturer's name <b>Layne</b> Model number <b>12K</b> HP <b>110</b> Volts Length of drop pipe <b>300</b> ft. capacity <b>800</b> g.m.p. Type: <input type="checkbox"/> Submersible <input checked="" type="checkbox"/> Turbine <input type="checkbox"/> Jet <input type="checkbox"/> Reciprocating <input type="checkbox"/> Centrifugal <input type="checkbox"/> Other						
				16 Remarks: elevation				17 Water well contractor's certification: This well was drilled under my jurisdiction and this report is true to the best of my knowledge and belief. <b>Layne-Western Co. 150</b> Business name License No. Address <b>Garden City, Ks.</b> Signed <b>[Signature]</b> Date <b>3-19-75</b> Authorized representative <b>5-19-75</b>		

TEST HOLE REPORT

Layne-Western Company, Inc.



WATER SUPPLY SERVICES SINCE 1924

TEST DRILLING • WATER WELLS • PUMPS

Contract Name Paul Nix

Job No. K-470

Date 10-26-74

City Hugoton

State Kansas

Driller McIntyre

TEST HOLE

No. 3-74

Location of Test Hole SW corner of

Grid for well location

Elevation of Test Hole

Static Water Level 130' Approx.

Measured Hours After Completion

1/4 NW 1/4 Sec. 31 of T. 33S

R. 35W, Stevens Co., Kansas

Table with columns: From, To, Description of Strata, Water Bearing. Contains stratigraphic data from 0 to 500 feet depth.

Remarks: