

WATER WELL RECORD

Form WWC-5

Division of Water Resources; App. No.


1 LOCATION OF WATER WELL: County: Stevens	Fraction SW ¼ NW ¼ NE ¼	Section Number 19	Township Number T 33 S	Range Number R 36 E/W
--	-----------------------------------	-----------------------------	----------------------------------	---------------------------------

Distance and direction from nearest town or city street address of well if located within city? **5 West of Hugoton**

Global Positioning System (decimal degrees, min. of 4 digits)
 Latitude: _____
 Longitude: _____
 Elevation: _____
 Datum: _____
 Data Collection Method: _____

2 WATER WELL OWNER: **Jim Persinger**
 RR#, St. Address, Box # : **1115 S Monroe**
 City, State, ZIP Code : **Hugoton KS67951**

3 LOCATE WELL'S LOCATION WITH AN "X" IN SECTION BOX:

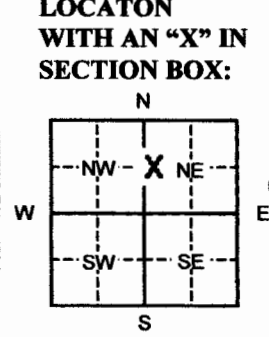

4 DEPTH OF COMPLETED WELL 330 ft.

Depth(s) Groundwater Encountered 1 **170** ft. 2 _____ ft. 3 _____ ft.

WELL'S STATIC WATER LEVEL **170** ft. below land surface measured on mo/day/yr **9/5/06**

Pump test data: Well water was _____ ft. after _____ hours pumping _____ gpm

Est. Yield _____ gpm: Well water was _____ ft. after _____ hours pumping _____ gpm

WELL WATER TO BE USED AS: 5 Public water supply 8 Air conditioning 11 Injection well

① Domestic 3 Feed lot 6 Oil field water supply 9 Dewatering 12 Other (Specify below)

2 Irrigation 4 Industrial 7 Domestic (lawn & garden) 10 Monitoring well

Was a chemical/bacteriological sample submitted to Department? Yes _____ No **x**; If yes, mo/day/yr
 Sample was submitted _____ Water Well Disinfected? Yes **x** No _____

5 TYPE OF CASING USED:

1 Steel	3 RMP (SR)	6 Asbestos-Cement	9 Other (specify below)	CASING JOINTS: Glued _____ Clamped _____
② PVC	4 ABS	7 Fiberglass	Eagle-Loc	Welded _____ Threaded _____

Blank casing diameter **5** in. to **330** ft., Dia _____ in. to _____ ft., Dia _____ in. to _____ ft.

Casing height above land surface **18** in., Weight _____ lbs./ft. Wall thickness or gauge No. **SDR21&17**

TYPE OF SCREEN OR PERFORATION MATERIAL:

1 Steel	3 Stainless steel	5 Fiberglass	⑦ PVC	9 ABS	11 Other (specify) _____
2 Brass	4 Galvanized steel	6 Concrete tile	8 RM (SR)	10 Asbestos-Cement	12 None used (open hole)

SCREEN OR PERFORATION OPENINGS ARE:

1 Continuous slot	③ Mill slot	5 Guaze wrapped	7 Torch cut	9 Drilled holes	11 None (open hole)
2 Louvered shutter	4 Key punched	6 Wire wrapped	8 Saw Cut	10 Other (specify) _____	

SCREEN-PERFORATED INTERVALS:

From 255 ft. to 275 ft.	From 295 ft. to 315 ft.
From _____ ft. to _____ ft.	From _____ ft. to _____ ft.

GRAVEL PACK INTERVALS:

From 25 ft. to 330 ft.	From _____ ft. to _____ ft.
From _____ ft. to _____ ft.	From _____ ft. to _____ ft.

6 GROUT MATERIAL: 1 Neat cement 2 Cement grout ③ Bentonite 4 Other _____

Grout Intervals From **5** ft. to **25** ft. From _____ ft. to _____ ft. From _____ ft. to _____ ft.

What is the nearest source of possible contamination:

1 Septic tank	4 Lateral lines	7 Pit privy	10 Livestock pens	13 Insecticide Storage	16 Other (specify below)
2 Sewer lines	5 Cess pool	8 Sewage lagoon	11 Fuel storage	14 Abandoned water well	
3 Watertight sewer lines	6 Seepage pit	9 Feedyard	12 Fertilizer storage	15 Oil well/ gas well	None observed

Direction from well? _____ How many feet? _____

FROM	TO	LITHOLOGIC LOG	FROM	TO	PLUGGING INTERVALS
0	10	Fine sand	280	300	Sand, fine to coarse
10	31	Gray clay	300	330	Brown sticky clay
31	94	Fine to med sand			
94	97	Brown rock			
97	102	Caliche			
102	191	Sandy clay			
191	197	Sand, med			
197	206	Brown, sandy clay			
206	213	Sand, med			
213	280	Brown sandy clay & sand streaks			

7 CONTRACTOR'S OR LANDOWNER'S CERTIFICATION: This water well was ① constructed, (2) reconstructed, or (3) plugged under my jurisdiction and was completed on (mo/day/year) **9/6/06** and this record is true to the best of my knowledge and belief.

Kansas Water Well Contractor's License No. **473**. This Water Well Record was completed on (mo/day/year) **9/12/06** under the business name of **Tyler Water Well Inc.** by (signature) *Tyler Water Well Inc.*

INSTRUCTIONS: Please fill in blanks or circle the correct answers. Send top three copies to Kansas Department of Health and Environment, Bureau of Water, Resources Section, 1000 SW Jackson St., Suite 420, Topeka, Kansas 66612-1367. Telephone 785-296-5522. Send one to WATER WELL OWNER and retain one for your records. Fee of \$5.00 for each constructed well. Visit us at <http://www.kdheks.gov/waterwell>.