

1 LOCATION OF WATER WELL. Fraction SW 1/4 NE 1/4 Section Number 12 Township Number T 33 S Range Number R 36 EW  

Distance and direction from nearest town or city street address of well if located within city?

From Hugoton - East on Hwy 51 - 9 miles - North on Road 22 - 2 miles

2 WATER WELL OWNER Shannon Chowford

RR# St. Address. Box #

707 S. Polk


Board of Agriculture, Division of Water Resources

Civ. State. ZIP Code

Hugoton, KS 67957

Application Number:

3 LOCATE WELL'S LOCATION WITH AN "X" IN SECTION BOX

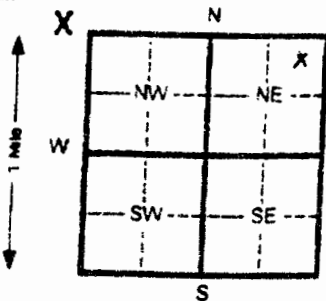

4 DEPTH OF COMPLETED WELL

410 ft. ELEVATION:

Depth(s) Groundwater Encountered 1 ft. 2 ft. 3 ft.

WELL'S STATIC WATER LEVEL 250 ft. below land surface measured on mo/day/yr

Pump test data: Well water was ft. after hours pumping gpm

Est. Yield gpm Well water was ft. after hours pumping gpm

Bore Hole Diameter in to ft. and in to ft.

WELL WATER TO BE USED AS: 1 Domestic 3 Feed lot 5 Public water supply 8 Air conditioning 11 Injection well

2 Irrigation 4 Industrial 7 Lawn and garden (domestic) 9 Dewatering 12 Other (Specify below)

Was a chemical/bacteriological sample submitted to Department? Yes No ☒ If yes, mo/day/yr sample was submitted

Water Well Disinfected? Yes No

5 TYPE OF BLANK CASING USED

1 Steel  
2 PVC

3 RMP (SR)  
4 ABS

5 Wrought iron  
6 Asbestos-Cement  
7 Fiberglass

8 Concrete tile  
9 Other (specify below)

CASING JOINTS: Glued Clamped  
Welded  
Threaded

Blank casing diameter 16" in. to ft. Dia in. to ft. Dia in. to ft.

Casing height above land surface in. weight lbs./ft. Wall thickness or gauge No

TYPE OF SCREEN OR PERFORATION MATERIAL

1 Steel 3 Stainless steel  
2 Brass 4 Galvanized steel

5 Fiberglass 8 RMP (SR)  
6 Concrete tile 9 ABS

10 Asbestos-cement  
11 Other (specify)

SCREEN OR PERFORATION OPENINGS ARE:

1 Continuous slot 3 Mill slot  
2 Louvered shutter 4 Key punched

5 Gauzed wrapped  
6 Wire wrapped  
7 Torch cut

8 Saw cut 11 None (open hole)  
9 Drilled holes  
10 Other (specify)

SCREEN-PERFORATED INTERVALS: From ft. to ft. From ft. to ft.

GRAVEL PACK INTERVALS: From ft. to ft. From ft. to ft.

6 GROUT MATERIAL

1 Neat cement

2 Cement grout

3 Bentonite

4 Other

Grout intervals From ft. to ft. From ft. to ft. From ft. to ft.

What is the nearest source of possible contamination:

1 Septic tank 4 Lateral lines  
2 Sewer lines 5 Cess pool  
3 Watertight sewer lines 6 Seepage pit

7 Pit privy  
8 Sewage lagoon  
9 Feedyard

10 Livestock pens 14 Abandoned water well  
11 Fuel storage 15 Oil well/ Gas well  
12 Fertilizer storage 16 Other (specify below)  
13 Insecticide storage

Direction from well?

How many feet?

FROM TO CODE LITHOLOGIC LOG FROM TO PLUGGING INTERVALS

410 225 Gravel Fill  
225 217 Bentonite Plug  
217 215 Compact Silt  
215 4 Cement Plug

7 CONTRACTOR'S OR LANDOWNER'S CERTIFICATION: This water well was (1) constructed, (2) reconstructed, or (3) plugged under my jurisdiction and was

completed on (mo/day/yr)

12-2-06

and this record is true to the best of my knowledge and belief Kansas

Water Well Contractor's License No.

473

This Water Well Record was completed on (mo/day/yr) 12-11-06

under the business name of

Tyler Water Well Serv

by (signature)

Paul J. L.

INSTRUCTIONS Please fill in blanks and circle the correct answers. Send three copies to Kansas Department of Health and Environment, Bureau of Water, Topeka.

Kansas 66520-0001 Telephone: 913-286-5545. Send one to WATER WELL OWNER and retain one for your records.