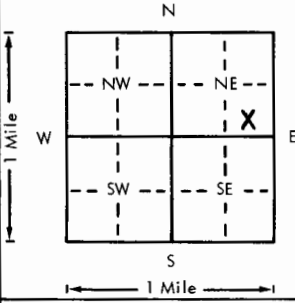


USE TYPEWRITER OR BALL POINT PEN—PRESS FIRMLY, PRINT CLEARLY.

WATER WELL RECORD
KSA 82a-1201-1215

Kansas Department of Health and Environment—Division of Environment
(Water well Contractors)
Topeka, Kansas 66620

1. Location of well:	County STEVENS	Fraction SE 1/4 SE 1/4 NE 1/4	Section number 2	Township number T 33 S	Range number R 36 E/W
2. Distance and direction from nearest town or city: 8 miles east 2 1/2 North of Hugoton, KS Street address of well location if in city:			3. Owner of well: WRIGHT, LOWERY AND WILLIAMS R.R. or street: Box 549 City, state, zip code: Woodward, OK 73801		
4. Locate with "X" in section below: Sketch map: 			6. Bore hole dia. <u>26</u> in. Completion date 9-20-78 Well depth <u>443</u> ft.		
5. Type and color of material			7. <input type="checkbox"/> Cable tool <input checked="" type="checkbox"/> Rotary <input type="checkbox"/> Driven <input type="checkbox"/> Dug <input type="checkbox"/> Hollow rod <input type="checkbox"/> Jetted <input type="checkbox"/> Bored <input type="checkbox"/> Reverse rotary		
			8. Use: <input type="checkbox"/> Domestic <input type="checkbox"/> Public supply <input type="checkbox"/> Industry <input checked="" type="checkbox"/> Irrigation <input type="checkbox"/> Air conditioning <input type="checkbox"/> Stock <input type="checkbox"/> Lawn <input type="checkbox"/> Oil field water <input type="checkbox"/> Other		
			9. Casing: Material <u>Steel</u> Height: Above or below Threaded <input type="checkbox"/> Welded <input checked="" type="checkbox"/> Surface <u>12</u> in. RMP <input type="checkbox"/> PVC <input type="checkbox"/> Weight <u>42.5</u> lbs./ft. Dia. <u>16</u> in. to <u>443</u> ft. depth Wall Thickness: inches or Dia. <input type="checkbox"/> in. to <input type="checkbox"/> ft. depth gage No. <u>250</u>		
			10. Screen: Manufacturer's name _____ Type <u>Steel</u> Dia. <u>16</u> Slot/gauze <u>1/8</u> Length <u>30</u> Set between <u>230</u> ft. and <u>240</u> ft. <u>404</u> ft. and <u>424</u> ft. Gravel pack? <input checked="" type="checkbox"/> Size range of material <u>1/8-1/4</u>		
			11. Static water level: _____ mo./day/yr. <u>115</u> ft. below land surface Date 9-25-78		
			12. Pumping level below land surfaces: _____ ft. after _____ hrs. pumping _____ g.p.m. _____ ft. after _____ hrs. pumping _____ g.p.m. Estimated maximum yield _____ g.p.m.		
			13. Water sample submitted: _____ mo./day/yr. <input type="checkbox"/> Yes <input checked="" type="checkbox"/> No Date _____		
			14. Well head completion: <input type="checkbox"/> Pitless adapter _____ inches above grade		
			15. Well grouted? _____ With: <input checked="" type="checkbox"/> Neat cement <input type="checkbox"/> Bentonite <input type="checkbox"/> Concrete Depth: From <u>0</u> ft. to <u>10</u> ft.		
			16. Nearest source of possible contamination: ft. _____ Direction _____ Type _____ Well disinfected upon completion? <input type="checkbox"/> Yes <input checked="" type="checkbox"/> No		
17. Pump: <input checked="" type="checkbox"/> Not installed Manufacturer's name _____ Model number _____ HP _____ Volts _____ Length of drop pipe _____ ft. capacity _____ g.p.m. Type: <input type="checkbox"/> Submersible <input type="checkbox"/> Turbine <input type="checkbox"/> Jet <input type="checkbox"/> Reciprocating <input type="checkbox"/> Centrifugal <input type="checkbox"/> Other					
(Use a second sheet if needed)					
18. Elevation: Topography: <input type="checkbox"/> Hill <input checked="" type="checkbox"/> Slope <input type="checkbox"/> Upland <input type="checkbox"/> Valley	19. Remarks: Perf. 203-230 240-404 424-443 16. Cropland		20. Water well contractor's certification: This well was drilled under my jurisdiction and this report is true to the best of my knowledge and belief. KTM DRILLING, INC. 225 Business name _____ License No. _____ Address Box 1385, Guzman, OK Signed <u>[Signature]</u> Date <u>9/25/78</u> Authorized representative		

33
 36
 2
 SESENE
 1/4 1/4 1/4