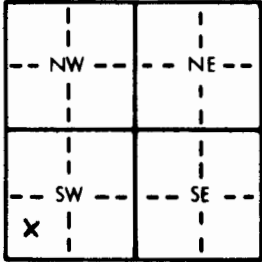
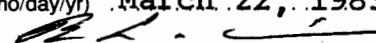


1 LOCATION OF WATER WELL:		Fraction	Section Number	Township Number	Range Number
County: Stevens		$\frac{3}{4}$ C-SW $\frac{1}{4}$ SW $\frac{1}{4}$	3	T 33 S 36 E	EW
Distance and direction from nearest town or city street address of well if located within city: From Liberal go 9mi North 16 West to Moscow Blacktop then 2mi North 3/4mi West and North to location.					
2 WATER WELL OWNER:		Oil Company Lamex Drilling			
RR#, St. Address, Box #: RFD #1		Board of Agriculture, Division of Water Resources			
City, State, ZIP Code: Hugoton, Kansas 67951		Application Number: T 83-83			
3 LOCATE WELL'S LOCATION WITH AN "X" IN SECTION BOX:		4 DEPTH OF COMPLETED WELL: 280 ft. ELEVATION:			
<div style="text-align: center;"></div>		Depth(s) Groundwater Encountered 1. 180 ft. 2. ft. 3. ft.			
		WELL'S STATIC WATER LEVEL ... 100 ... ft. below land surface measured on mo/day/yr ... 3/15/83			
		Pump test data: Well water was ft. after hours pumping gpm			
		Est. Yield 60 ... gpm: Well water was ft. after hours pumping gpm			
Bore Hole Diameter. ... 9 ... in. to ... 280 ... ft., and, in. to ft.		WELL WATER TO BE USED AS:			
1 Domestic		3 Feedlot	6 Oil field water supply	9 Dewatering	12 Other (Specify below)
2 Irrigation		4 Industrial	7 Lawn and garden only	10 Observation well	
Was a chemical/bacteriological sample submitted to Department? Yes..... <u>No</u>; If yes, mo/day/yr sample was submitted					
Water Well Disinfected? Yes..... No.....					
5 TYPE OF BLANK CASING USED:					
1 Steel		3 RMP (SR)	6 Asbestos-Cement	9 Other (specify below)	Welded
2 PVC		4 ABS	7 Fiberglass		Threaded
Blank casing diameter ... 5 ... in. to ... 180 ... ft., Dia ... in. to ... ft., Dia ... in. to ... ft.					
Casing height above land surface ... 28 ... in., weight ... 2.78 ... lbs./ft. Wall thickness or gauge No. ... 256					
TYPE OF SCREEN OR PERFORATION MATERIAL:					
1 Steel		3 Stainless steel	5 Fiberglass	8 RMP (SR)	11 Other (specify)
2 Brass		4 Galvanized steel	6 Concrete tile	9 ABS	12 None used (open hole)
SCREEN OR PERFORATION OPENINGS ARE:					
1 Continuous slot		3 Mill slot	6 Wire wrapped	9 Drilled holes	
2 Louvered shutter		4 Key punched	7 Torch cut	10 Other (specify)	
SCREEN-PERFORATED INTERVALS:					
From ... 180 ... ft. to ... 280 ... ft., From ... ft. to ... ft.					
From ... ft. to ... ft., From ... ft. to ... ft.					
GRAVEL PACK INTERVALS:					
From ... 100 ... ft. to ... 280 ... ft., From ... ft. to ... ft.					
From ... ft. to ... ft., From ... ft. to ... ft.					
6 GROUT MATERIAL:					
1 Neat cement		2 Cement grout	3 Bentonite	4 Other	
Grout Intervals: From ... 0 ... ft. to ... 10 ... ft., From ... ft. to ... ft., From ... ft. to ... ft.					
What is the nearest source of possible contamination:					
1 Septic tank		4 Lateral lines	7 Pit privy	10 Livestock pens	14 Abandoned water well
2 Sewer lines		5 Cess pool	8 Sewage lagoon	11 Fuel storage	15 Oil well/Gas well
3 Watertight sewer lines		6 Seepage pit	9 Feedyard	12 Fertilizer storage	16 Other (specify below)
				13 Insecticide storage	
Direction from well? Northeast of water well.					
How many feet? 100'					
FROM	TO	LITHOLOGIC LOG	FROM	TO	LITHOLOGIC LOG
0	2	surface			
2	43	clay			
43	65	sandy clay			
65	78	gravel			
78	123	sandy clay			
123	136	caliche			
136	160	sandy clay			
160	190	fine sand			
190	253	medium to large sand			
253	258	caliche			
258	265	sandy clay			
265	280	clay			
7 CONTRACTOR'S OR LANDOWNER'S CERTIFICATION: This water well was (1) constructed, (2) reconstructed, or (3) plugged under my jurisdiction and was completed on (mo/day/year) March 15, 1983 and this record is true to the best of my knowledge and belief. Kansas Water Well Contractor's License No. 118 This Water Well Record was completed on (mo/day/yr) March 22, 1983 under the business name of Carlile Water Well Service, Inc. by (signature) 					
INSTRUCTIONS: Use typewriter or ball point pen, PLEASE PRESS FIRMLY and PRINT clearly. Please fill in blanks, underline or circle the correct answers. Send top three copies to Kansas Department of Health and Environment, Division of Environment, Environmental Geology Section, Topeka, KS 66620. Send one to WATER WELL OWNER and retain one for your records.					

OFFICE USE ONLY

T

R

3

EW

SEC.

3

C

1/4

S

W

1/4

S

W

1/4