

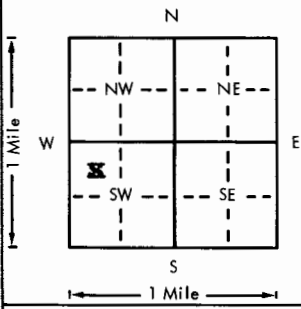
USE TYPEWRITER OR BALL  
POINT PEN-PRESS FIRMLY,  
PRINT CLEARLY.

WATER WELL RECORD  
KSA 82a-1201-1215

Kansas Department of Health and  
Environment-Division of Environment  
(Water well Contractors)  
Topeka, Kansas 66620

CWW Inv. #13870

Lemert #1

1. Location of well:		County <b>Stevens</b>	Fraction <b>1/4 SW 1/4 SW 1/4</b>	Section number <b>4</b>	Township number <b>T 33S</b>	Range number <b>S R 36W E/W</b>
2. Distance and direction from nearest town or city:		From <b>jct. Moscow road &amp; hwy 270 go 2m We. - 2 1/4 m. No. East to location</b>				
Street address of well location if in city:		R.R. or street: <b>Suite 600, 200 W. Douglas</b> City, state, zip code: <b>Wichita, Kansas 67202</b>				
4. Locate with "X" in section below:		Sketch map:				6. Bore hole dia. <b>09</b> in. Completion date <b>9-27</b> Well depth <b>260</b> ft.
						7. <input checked="" type="checkbox"/> Cable tool <input checked="" type="checkbox"/> Rotary <input type="checkbox"/> Driven <input type="checkbox"/> Dug <input type="checkbox"/> Hollow rod <input type="checkbox"/> Jetted <input type="checkbox"/> Bored <input type="checkbox"/> Reverse rotary
5. Type and color of material		From	To	8. Use: <input type="checkbox"/> Domestic <input type="checkbox"/> Public supply <input checked="" type="checkbox"/> Industry <input type="checkbox"/> Irrigation <input type="checkbox"/> Air conditioning <input type="checkbox"/> Stock <input type="checkbox"/> Lawn <input checked="" type="checkbox"/> Oil field water <input type="checkbox"/> Other		
Surface		0	2	9. Casing: Material <input type="checkbox"/> Height: <b>Above</b> or below Threaded <input type="checkbox"/> Welded <input type="checkbox"/> Surface <b>28</b> in. RMP <input type="checkbox"/> PVC <input checked="" type="checkbox"/> Weight <b>2.78</b> lbs./ft. Dia. <b>5</b> in. to <b>105</b> ft. depth Wall Thickness: inches or Dia. <b>5</b> in. to <b>260</b> ft. depth Gauge No. <b>265</b>		
Clay		2	36	10. Screen: Manufacturer's name <b>Sawed perf.</b> Type <b>PVC</b> Dia. <b>5"</b> Slot/gauze <input type="checkbox"/> Length <b>100'</b> Set between <b>105</b> ft. and <b>145</b> ft. <b>185-205</b> ft. and <b>215-225</b> ft. Gravel pack? <b>yes</b> Size range of material <b>1/8-3/16</b>		
Fine sand & medium to large sand		36	120	11. Static water level: <input type="checkbox"/> mo./day/yr. <b>100</b> ft. below land surface Date <b>9/27/77</b>		
Clay 40%, & medium to large sand		120	140	12. Pumping level below land surfaces: ____ ft. after ____ hrs. pumping ____ g.p.m. ____ ft. after ____ hrs. pumping ____ g.p.m. Estimated maximum yield <b>60</b> g.p.m.		
Clay		140	180	13. Water sample submitted: <input type="checkbox"/> mo./day/yr. <input type="checkbox"/> Yes <input checked="" type="checkbox"/> No Date ____		
Clay 40%, Fine sand & medium to large sand		180	200	14. Well head completion: <input type="checkbox"/> Pitless adapter <b>28</b> inches above grade		
Clay		200	210	15. Well grouted? <b>yes</b> With: <input checked="" type="checkbox"/> Neat cement <input type="checkbox"/> Bentonite <input type="checkbox"/> Concrete Depth: From <b>0</b> ft. to <b>10</b> ft.		
Clay 40%, Fine sand & medium to large sand		210	260	16. Nearest source of possible contamination: ft. <b>100</b> Direction <b>NE</b> Type <b>oilwell</b> Well disinfected upon completion? <input checked="" type="checkbox"/> Yes <input type="checkbox"/> No		
				17. Pump: <input checked="" type="checkbox"/> Not installed Manufacturer's name _____ Model number _____ HP _____ Volts _____ Length of drop pipe _____ ft. capacity _____ g.p.m. Type: <input type="checkbox"/> Submersible <input type="checkbox"/> Turbine <input type="checkbox"/> Jet <input type="checkbox"/> Reciprocating <input type="checkbox"/> Centrifugal <input type="checkbox"/> Other		
18. Elevation:		19. Remarks:		20. Water well contractor's certification: This well was drilled under my jurisdiction and this report is true to the best of my knowledge and belief. <b>Carlile Water Well 118</b> Business name _____ License No. _____ Address <b>Box 275, Liberal, KS</b> Signed <b>Edward E. Means</b> Date <b>10/11/77</b> Authorized representative		