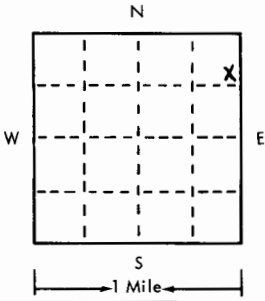


USE TYPEWRITER OR BALL
POINT PEN-PRESS FIRMLY,
PRINT CLEARLY.

WATER WELL RECORD
KSA 82a-1201-1215

T R EW sec 1/4 1/4 1/4 No.

Kansas State Dept. Of Health
(Water Well Contractors)
Forbes-Bldg. 740
Topeka, Kansas 66620

1 Location of well:		County Stearns	Township name	Fraction SE 1/4 NE 1/4 NE 1/4	Section number 12	Town number T33 S	Range number R 36 W
Distance and direction from nearest town or city:				3 Owner of well: Mr. G. E. Harmon			
Street address of well location if in city:				Address: HUGOTON, Kansas RFD. I			
Locate with "X" in section below:		Sketch map:		4 Well depth: 240 ft. Date of completion 4-12-75 Well diameter 10 in.			
				5 <input type="checkbox"/> Cable tool <input checked="" type="checkbox"/> Rotary <input type="checkbox"/> Driven <input type="checkbox"/> Dug <input type="checkbox"/> Hollow rod <input type="checkbox"/> Jetted <input type="checkbox"/> Bored <input type="checkbox"/> Reverse rotary			
2		Type and color of material		From	To	6 Use: <input checked="" type="checkbox"/> Domestic <input type="checkbox"/> Public supply <input type="checkbox"/> Industry <input type="checkbox"/> Irrigation <input type="checkbox"/> Air conditioning <input type="checkbox"/> Commercial <input type="checkbox"/> Test well <input type="checkbox"/>	
		dark sandy top soil		0	4	7 Casing: Material PRC Height: Above below Threaded <input type="checkbox"/> Welded <input type="checkbox"/> Surface 18 in. Diam. 5 in. to 240 ft. depth Drive shoe? <input type="checkbox"/> Yes <input checked="" type="checkbox"/> No 5 in. to 240 ft. depth	
		sand - brown - fine		4	70	8 Screen: sawed Manufacturer Penn P Co Type Polyvinyl chl Dia. 5 Slot/gauze 1/2 Length 20' Set between 220 ft. and 240 ft. Fittings: Gravel pack <input checked="" type="checkbox"/> Yes <input type="checkbox"/> No Size range of material 3/4	
		" " " some silt balls Tan		70	112	9 Static water level: 101 ft. below land surface Date 4-12-75	
		" " coarse tight 1/2 silt balls Tan		112	116	10 Pumping level below land surfaces: 127 ft. after 1 hrs. pumping 16 1/2 g.p.m. 127 ft. after 3 hrs. pumping 16 1/2 g.p.m. Estimated maximum yield _____ g.p.m.	
		silt balls Tan + jip rock white to tan		116	160	11 Water sample submitted: <input type="checkbox"/> Yes <input checked="" type="checkbox"/> No Date _____	
		clay silt compact + joint clays		160	176	12 Well head completion: <input checked="" type="checkbox"/> Pitless adapter <input type="checkbox"/> Inches above grade	
		joint clays + fine brown sand		176	180	13 Well grouted? <input checked="" type="checkbox"/> Yes <input type="checkbox"/> No <input type="checkbox"/> Neat cement <input checked="" type="checkbox"/> Bentonite <input type="checkbox"/> Depth: From 80 ft. to 40 ft.	
		silt balls Tan some sand brown at bottom		180	200	14 Nearest source of possible contamination: bored ft. 60 Direction SE Type septic T. Well disinfected upon completion? <input checked="" type="checkbox"/> Yes <input type="checkbox"/> No	
		silt balls Tan to brown large		200	208	15 Pump: <input type="checkbox"/> Not installed Manufacturer's name Acromotor Model number 5012 HP 1 Volts 230 Length of drop pipe 160 ft. capacity 16 1/2 g.p.m. Type: <input checked="" type="checkbox"/> Submersible <input type="checkbox"/> Turbine <input type="checkbox"/> Jet <input type="checkbox"/> Reciprocating <input type="checkbox"/> Centrifugal <input type="checkbox"/> Other	
		" " coarse sand + fine gravel		208	220	16 Remarks: elevation	
		fine gravel + coarse sand brown		220	240	17 Water well contractor's certification: This well was drilled under my jurisdiction and this report is true to the best of my knowledge and belief. Stocon Drilling 127 Business name HUGOTON Kansas License No. 62951 Address HUGOTON Kansas Signed Paul Stocon Date 4-17-75 Authorized representative	
		(use a second sheet if needed)					
		Topography: <input checked="" type="checkbox"/> Hill <input type="checkbox"/> Slope <input type="checkbox"/> Upland <input type="checkbox"/> Valley					