USE TYPEWRITER OR BALL POINT PEN-PRESS FIRMLY, PRINT CLEARLY.

WATER WELL RECORD
KSA 82a-1201-1215

Kansas Department of Health and Environment-Division of Environment
(Water well Contractors)
Topeka, Kansas 66620

1. Location of well:	County	Fraction	Section number	Township number	Range number
	Stevens	SE 1/4 SE 1/4 SE 1/4	23	T 33 S	R 36 E/W

2. Distance and direction from nearest town or city: 5½ W. of Woods & 1 S.
Street address of well location if in city:

3. Owner of well:
R.R. or street: Marlin Heger
City, state, zip code: Hugoton, Kansas

4. Locate with "X" in section below:

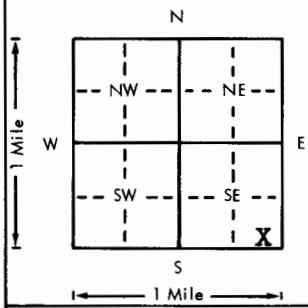

Sketch map:

6. Bore hole dia. 9 7/8 in. Completion date
Well depth 390 ft. 2-13-76

7. __ Cable tool X Rotary __ Driven __ Dug
__ Hollow rod __ Jetted __ Bored __ Reverse rotary

8. Use: X Domestic __ Public supply __ Industry
__ Irrigation __ Air conditioning __ Stock
__ Lawn __ Oil field water __ Other

X. Casing: Material PVC
Threaded ___ Welded X
RMP ___ PVC ___
Dia. 5 in. to 390 ft. depth
Dia. ___ in. to ___ ft. depth
Height: Above or below Surface 24 in.
Weight 291 lbs./ft. 100
Wall Thickness: inches or gage No. .320

X. Screen: Manufacturer's name Jess & Lowell
Type PVC Dia. 5"
Slot/gauze 1/8" Length ~~20'~~ 140
Set between 250 ft. and 390 ft.
___ ft. and ___ ft.
Gravel pack? yes Size range of material 3/16"

5. Type and color of material	From	To
Top soil	0	4
Clay	4	10
Medium sand	10	392

(Use a second sheet if needed)

11. Static water level: mo./day/yr.
183 ft. below land surface Date 2/13/76

12. Pumping level below land surfaces:
___ ft. after ___ hrs. pumping ___ g.p.m.
___ ft. after ___ hrs. pumping ___ g.p.m.
Estimated maximum yield 100 g.p.m.

13. Water sample submitted: mo./day/yr.
___ Yes X No Date

14. Well head completion:
X Pitless adapter 18 Inches above grade

15. Well grouted? yes
With: ___ Neat cement ___ Bentonite X Concrete
Depth: From 4 ft. to 14 ft.

16. Nearest source of possible contamination: none
ft. ___ Direction ___ Type ___
Well disinfected upon completion? X Yes ___ No

17. Pump: ___ Not installed
Manufacturer's name Aermotor
Model number SD 12 HP 2 Volts 220
Length of drop pipe 315 ft. capacity 10 g.p.m.
Type:
X Submersible ___ Turbine
___ Jet ___ Reciprocating
___ Centrifugal ___ Other

18. Elevation:
Topography:
___ Hill
___ Slope
X Upland
___ Valley

19. Remarks:

20. Water well contractor's certification:
This well was drilled under my jurisdiction and this report is true to the best of my knowledge and belief.
K Friesen Windmill 252
Business name License No.
Address Meade, Kansas 67864
Signed [signature] Date 2-1-76
Authorized representative

T 33 R 36 E/W Sec 23 1/4 SE 1/4 SE 1/4 SE 1/4

Forward the white, blue and pink copies to the Department of Health and Environment

Form WWC-5