


USE TYPEWRITER OR BALL POINT PEN-PRESS FIRMLY, PRINT CLEARLY.

WATER WELL RECORD
KSA 82a-1201-1215

Kansas Department of Health and Environment-Division of Environment
(Water well Contractors)
Topeka, Kansas 66620

1. Location of well: County **STEVENS** Fraction **SW 1/4 SW 1/4 SW 1/4** Section number **23** Township number **T 33N 33R 36W** Range number **E/W**

2. Distance and direction from nearest town or city: **7 miles East and 1 mile South from Hugoton, KS.**
Street address of well location if in city:
3. Owner of well: **ALBA WAYLAND**
R.R. or street: **P.O. BOX D**
City, state, zip code: **Hugoton, KS 67951**

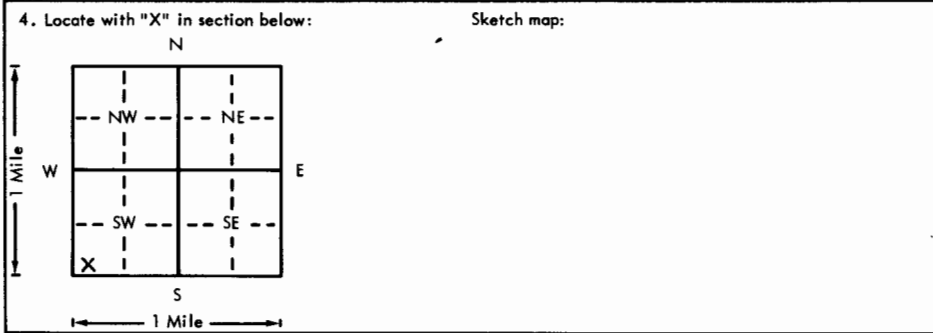

6. Bore hole dia. **26** in. Completion date **9-21-83**
Well depth **363** ft.
7. Cable tool Rotary Driven Dug
 Hollow rod Jetted Bored Reverse rotary
8. Use: Domestic Public supply Industry
 Irrigation Air conditioning Stock
 Lawn Oil field water Other
9. Casing: Material **Steel** Height: Above or below
Threaded Welded Surface **12** in.
RMP PVC Weight **42.5** lbs./ft.
Dia. **16** in. to **363** ft. depth Wall Thickness: inches or
Dia. in. to ft. depth gage No. **250**

| 5. Type and color of material | From | To |
|-------------------------------|------|---------|
| Top soil | 01 | 0 140 |
| Sand med. | 08 | 140 165 |
| Fine & clay | 01 | 165 200 |
| Clay | 01 | 200 245 |
| Fine sand | 07 | 245 265 |
| Fine sand & clay | 04 | 265 310 |
| Med. & fine sand | 05 | 310 340 |
| Fine sand & clay | 04 | 340 363 |
| Red clay | 01 | 363 365 |

10. Screen: Manufacturer's name _____
Type **Steel** Dia. **16"**
Slot/gauze **1/8** Length _____
Set between **310** ft. and **340** ft.
_____ ft. and _____ ft.
Gravel pack? **yes** Size range of material _____
11. Static water level: _____ mo./day/yr.
240 ft. below land surface Date _____
12. Pumping level below land surfaces: **N/A**
_____ ft. after _____ hrs. pumping _____ g.p.m.
_____ ft. after _____ hrs. pumping _____ g.p.m.
Estimated maximum yield _____ g.p.m.
13. Water sample submitted: _____ mo./day/yr.
Yes No Date _____
14. Well head completion:
 Pitless adapter **24** Inches above grade
15. Well grouted? **YES**
With: Neat cement Bentonite Concrete
Depth: From **0** ft. to **10** ft.
16. Nearest source of possible contamination:
ft. _____ Direction _____ Type _____
Well disinfected upon completion? _____ Yes No
17. Pump: Not installed
Manufacturer's name _____
Model number _____ HP _____ Volts _____
Length of drop pipe _____ ft. capacity _____ g.p.m.
Type:
 Submersible Turbine
 Jet Reciprocating
 Centrifugal Other

18. Elevation: Topography: Hill Slope Upland Valley
19. Remarks: **16. Cropland**
Perf. 243'-310'
& 340-363

20. Water well contractor's certification:
This well was drilled under my jurisdiction and this report is true to the best of my knowledge and belief.
KTM DRILLING, INC. 225
Business name **Box 1385, Guyman, OK** License No. _____
Address **Clayton** Date **9/21/83**
Signed _____ Authorized representative

23
36W
23
1/4
1/4
1/4
1/4
Sec