


USE TYPEWRITER OR BALL POINT PEN—PRESS FIRMLY, PRINT CLEARLY.

WATER WELL RECORD  
KSA 82a-1201-1215

Kansas Department of Health and Environment—Division of Environment (Water well Contractors)  
Topeka, Kansas 66620

1. Location of well: County STerens Fraction SE 1/4 SE 1/4 SE 1/4 Section number 26 Township number T 33 S R 26 Range number E/W

2. Distance and direction from nearest town or city: 8 E - 2 S of Hugoton, K.  
Street address of well location if in city:  
3. Owner of well: Rudolph Heger R.F.D.  
R.R. or street:  
City, state, zip code: Hugoton, Kansas 67951

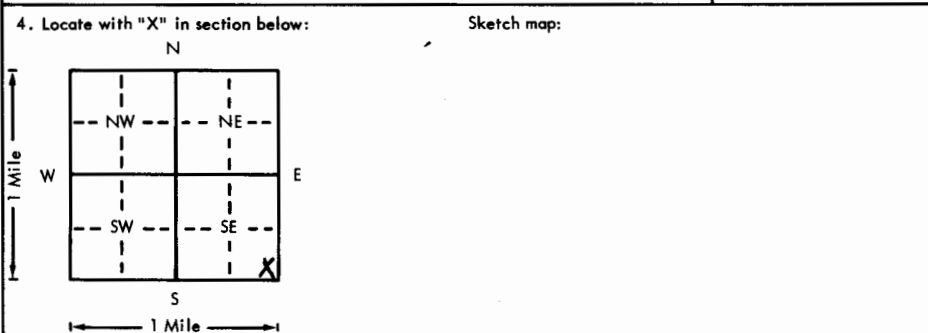

6. Bore hole dia. 10 in. Completion date 9-25-75  
Well depth 360 ft.

7.  Cable tool  Rotary  Driven  Dug  
 Hollow rod  Jetted  Bored  Reverse rotary

8. Use:  Domestic  Public supply  Industry  
 Irrigation  Air conditioning  Stock  
 Lawn  Oil field water  Other

9. Casing: Material \_\_\_\_\_ Height: Above or below  
Threaded \_\_\_\_\_ Welded \_\_\_\_\_ Surface 18' in.  
RMP \_\_\_\_\_ PVC  Weight 2.25 lbs./ft.  
Dia. 5 in. to 360 ft. depth Wall Thickness: inches or  
Dia. \_\_\_\_\_ in. to \_\_\_\_\_ ft. depth gage No. 250

5. Type and color of material	From	To
<u>Topsoil</u>	<u>0</u>	<u>2</u>
<u>silty light + sandy redish</u>	<u>2</u>	<u>40</u>
<u>brown sand w/ clays</u>	<u>40</u>	<u>80</u>
<u>" " coarse calcified in layers</u>	<u>80</u>	<u>108</u>
<u>Sand coarse + coarse Gravel</u>	<u>108</u>	<u>120</u>
<u>joint clays w/ sand silty</u>	<u>120</u>	<u>268</u>
<u>Sand fine to medium coarse</u>	<u>268</u>	<u>284</u>
<u>Clays w/ flint rock + sand fine to medium coarse</u>	<u>284</u>	<u>296</u>
<u>Sand coarse + fine Gravel</u>	<u>296</u>	<u>340</u>
<u>Sand coarse</u>	<u>340</u>	<u>360</u>
(Use a second sheet if needed)		

10. Screen: Manufacturer's name \_\_\_\_\_  
Type saw cut Dia. 5"  
Slot/gauze 1/2 Length 40'  
Set between 300 ft. and 320 ft.  
340 ft. and 360 ft.  
Gravel pack?  Size range of material 1/4" - 3/4"

11. Static water level: \_\_\_\_\_ mo./day/yr.  
210 ft. below land surface Date 9-29-75

12. Pumping level below land surfaces:  
210 ft. after 24 hrs. pumping 16 g.p.m.  
\_\_\_\_\_ ft. after \_\_\_\_\_ hrs. pumping \_\_\_\_\_ g.p.m.  
Estimated maximum yield 100 g.p.m.

13. Water sample submitted: \_\_\_\_\_ mo./day/yr.  
Yes  No  Date \_\_\_\_\_

14. Well head completion:  
 Pitless adapter 18 inches above grade

15. Well grouted?   
With:  Neat cement  Bentonite  Concrete  
Depth: From \_\_\_\_\_ ft. to \_\_\_\_\_ ft.

16. Nearest source of possible contamination:  
ft. 100 Direction W Type SEPTIC  
Well disinfected upon completion?  Yes  No

17. Pump: \_\_\_\_\_ Not installed  
Manufacturer's name Acmeator  
Model number SD12-150 HP 1.5 Volts 230  
Length of drop pipe 260 ft. capacity 16 g.p.m.  
Type:  
 Submersible  Turbine  
 Jet  Reciprocating  
 Centrifugal  Other

18. Elevation: \_\_\_\_\_  
Topography:  
 Hill  
 Slope  
 Upland  
 Valley

19. Remarks:  
The surface water at 150' falls to the lower water level 210'

20. Water well contractor's certification:  
This well was drilled under my jurisdiction and this report is true to the best of my knowledge and belief.  
Stacum Drilling 127  
Business name License No.  
Address Hugoton, Kansas  
Signed Paul Stacum Date 10-1-75  
Authorized representative