


USE TYPEWRITER OR BALL POINT PEN-PRESS FIRMLY, PRINT CLEARLY.

WATER WELL RECORD
KSA 82a-1201-1215

Kansas Department of Health and Environment-Division of Environment
(Water well Contractors)
Topeka, Kansas 66620

1. Location of well: County **Stevens** Fraction **NE 1/4 SW 1/4 SE 1/4** Section number **35** Township number **33** Range number **36**
T S R E/W

2. Distance and direction from nearest town or city: **7-3/4 East**
2-3/4 South of Hugonton, KS
Street address of well location if in city:
3. Owner of well: **WHEELER & SONS**
R.R. or street: **RR 1, Box 69**
City, state, zip code: **Hugoton, Kansas**

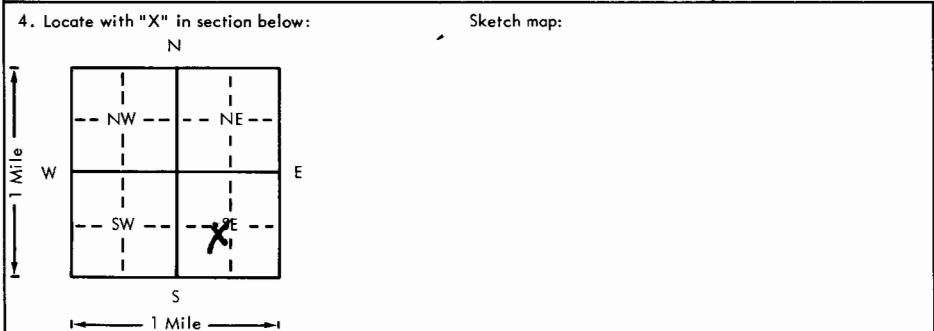

6. Bore hole dia: **26** in. Completion date **8-22-78**
Well depth **543** ft.

7. Cable tool Rotary Driven Dug
 Hollow rod Jetted Bored Reverse rotary

8. Use: Domestic Public supply Industry
 Irrigation Air conditioning Stock
 Lawn Oil field water Other

9. Casing: Material **Steel** Height: Above or below
Threaded Welded **6** Surface **12** in.
RMP PVC Weight **42.05** lbs./ft.
Dia. **16** in. to **543** ft. depth Wall Thickness: inches or
Dia. in. to ft. depth gage No. **250**

5. Type and color of material	From	To
Overburden	0	140
Clay	140	180
Fine sand & clay	180	260
Med sand & clay	260	300
Med to coarse sand & clay	300	340
Coarse sand	340	400
Med sand to coarse sand	400	460
Med sand w/red clay	460	520
Fine sand w/red clay	520	569
(Use a second sheet if needed)		

10. Screen: Manufacturer's name _____
Type **Steel** Dia. **16**
Slot/gauze **1/8** Length **3"** **SEE BELOW**
Set between **300** ft. and **430** ft.
Gravel pack? Size range of material **1/8-1/4** ft.

11. Static water level: **265'** ft. below land surface Date **9-14-78** mo./day/yr.

12. Pumping level below land surfaces:
_____ ft. after _____ hrs. pumping _____ g.p.m.
_____ ft. after _____ hrs. pumping _____ g.p.m.
Estimated maximum yield _____ g.p.m.

13. Water sample submitted: _____ mo./day/yr.
 Yes No Date _____

14. Well head completion:
 Pitless adapter _____ Inches above grade

15. Well grouted? _____
With: Neat cement Bentonite Concrete
Depth: From **0** ft. to **10** ft.

16. Nearest source of possible contamination:
ft. _____ Direction _____ Type _____
Well disinfected upon completion? Yes No

17. Pump: Not installed
Manufacturer's name _____
Model number _____ HP _____ Volts _____
Length of drop pipe _____ ft. capacity _____ g.p.m.
Type:
 Submersible Turbine
 Jet Reciprocating
 Centrifugal Other

18. Elevation: Topography: _____ Hill _____ Slope Upland _____ Valley

19. Remarks:
10. Johnson Irrigation
380-430
Perf. **3XB** 1/8 x 3" **240 - 380**
430-543
16. Cropland

20. Water well contractor's certification:
This well was drilled under my jurisdiction and this report is true to the best of my knowledge and belief.
KTM DRILLING, INC. 225
Business name _____ License No. _____
Address **Box 1385, Guyman, OK**
Signed **Clifton A. ...** Date **9/14/78**
Authorized representative

33
360
35
NE USE
1/4 1/4 1/4