


1	LOCATION OF WATER WELL:	Fraction	Section Number	Township Number	Range Number
County: <b>Stevens</b>		<b>SE 1/4 NW 1/4 NE 1/4</b>	<b>16</b>	<b>33</b>	<b>37</b>

Distance and direction from nearest town or city street address of well if located within city?

2 Halliburton **Veterans Hall**  
 RR#, St. Address, Box # **300 S. Monroe** Board of Agriculture, Division of Water Resources  
 City, State, ZIP Code : **Hugoton, Ks 67951** Application Number:

3 MARK WELL'S LOCATION WITH AN "X" IN SECTION BOX:

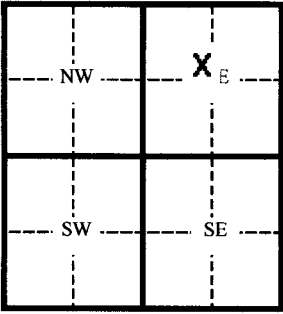

DEPTH OF WELL **146** ft.  
 WELL'S STATIC WATER LEVEL **106** ft.

WELL WAS USED AS:

1 Domestic	5 Public Water Supply	9 Dewatering
2 Irrigation	6 Oil Field Water Supply	<input checked="" type="checkbox"/> 10 Monitoring Well
3 Feedlot	7 Lawn and Garden (domestic)	11 Injection Well
4 Industrial	8 Air Conditioning	12 Other

Was a chemical/bacteriological sample submitted to Department? Yes \_\_\_\_\_ No   
 If yes, mo/day/yr sample was submitted \_\_\_\_\_  
 Water Well Disinfected: Yes \_\_\_\_\_ No

5 TYPE OF BLANK CASING USED:

1 Steel	3 RMP (SR)	5 Wrought	7 Fiberglass	9 Other (specify below)
<input checked="" type="checkbox"/> 2 PVC	4 ABC	6 Asbestos-Cement	8 Concrete Tile	<b>OVERDRILLED 3 FT</b>

Blank casing diameter **4** in. Was casing pulled? Yes \_\_\_\_\_ No \_\_\_\_\_ If yes, how much \_\_\_\_\_  
 Casing height above or below land surface **- 3 FT** in.

6 GROUT PLUG MATERIAL: 1 Neat cement 2 Cement grout  3 Bentonite 4 Other \_\_\_\_\_

Grout Plug Intervals From **146** ft. to **3** ft. From \_\_\_\_\_ ft. to \_\_\_\_\_ ft. From \_\_\_\_\_ ft. to \_\_\_\_\_ ft.

What is the nearest source of possible contamination:

1 Septic tank	6 Seepage pit	11 Fuel storage	16 Other (specify below)
2 Sewer lines	7 Pit privy	12 Fertilizer storage	
3 Watertight sewer lines	8 Sewage lagoon	13 Insecticide storage	
4 Lateral lines	9 Feedyard	14 Abandoned water well	
5 Cess Pool	10 Livestock pens	15 Oil well/ Gas well	

Direction from well? \_\_\_\_\_ How many feet? \_\_\_\_\_

FROM	TO	CODE	PLUGGING MATERIALS
<b>146</b>	<b>3</b>		<b>BENTONITE GROUT</b>
			<b>OVERDRILLED 3 FT</b>
<b>3</b>	<b>0</b>		<b>BACKFILL</b>

7 on (mo/day/yr) **03-09-06** and this record is true to the best of my knowledge and belief. Kansas  
 Water Well Contractor's License No. **554** This Water Well Record was completed on (mo/day/yr)  
**04-14-06** under the business name of **Woofter Pump & Well Inc.**  
 by (signature) \_\_\_\_\_ *Joyce Woofter*

INSTRUCTIONS: Please fill in blanks and circle the correct answers. Send three copies to Kansas Department of Health and Environment, Bureau of Water, 1000 S W Jackson St., Ste. 420, Topeka, Kansas 66620-0001. Telephone: 785-296-3565. Send one to Water Well Owner and retain one for your records.