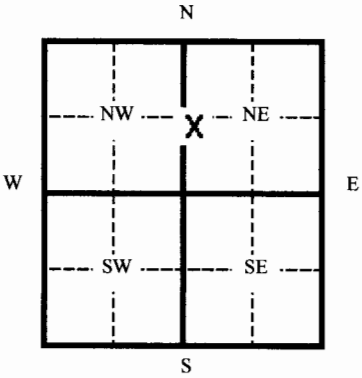
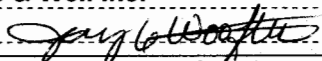


1 LOCATION OF WATER WELL:	Fraction NW ¼ SW ¼ NE ¼	Section Number 16	Township Number 33	Range Number 37
County: Stevens				
Distance and direction from nearest town or city street address of well if located within city?				
2 WATER WELL OWNER: City of Hugoton				
RR#, St. Address, Box # 112 #. 5th St		Board of Agriculture, Division of Water Resources		
City, State, ZIP Code : Hugoton, Ks 67951		Application Number:		
3 MARK WELL'S LOCATION WITH AN "X" IN SECTION BOX:	DEPTH OF WELL 140 ft.			
	WELL'S STATIC WATER LEVEL 130.25 ft.			
	WELL WAS USED AS:			
	1 Domestic 2 Irrigation 3 Feedlot 4 Industrial 5 Public Water Supply 6 Oil Field Water Supply 7 Lawn and Garden (domestic) 8 Air Conditioning 9 Dewatering 10 Monitoring Well 11 Injection Well 12 Other			
				
Was a chemical/bacteriological sample submitted to Department? Yes ___ No X				
If yes, mo/day/yr sample was submitted _____				
Water Well Disinfected: Yes ___ No X				
5 TYPE OF BLANK CASING USED:				
1 Steel 3 RMP (SR) 5 Wrought 7 Fiberglass 9 Other (specify below) 2 PVC 4 ABC 6 Asbestos-Cement 8 Concrete Tile OVERDRILLED 3 FT				
Blank casing diameter 4 in. Was casing pulled? Yes ___ No ___ If yes, how much _____				
Casing height above or below land surface - 3 FT in.				
6 GROUT PLUG MATERIAL: 1 Neat cement 2 Cement grout 3 Bentonite 4 Other _____				
Grout Plug Intervals From 140 ft. to 3 ft. From _____ ft. to _____ ft. From _____ ft. to _____ ft.				
What is the nearest source of possible contamination:				
1 Septic tank 6 Seepage pit 11 Fuel storage 16 Other (specify below) 2 Sewer lines 7 Pit privy 12 Fertilizer storage 3 Watertight sewer lines 8 Sewage lagoon 13 Insecticide storage 4 Lateral lines 9 Feedyard 14 Abandoned water well 5 Cess Pool 10 Livestock pens 15 Oil well/ Gas well				
Direction from well? _____ How many feet? _____				
FROM	TO	CODE	PLUGGING MATERIALS	
140	3		BENTONITE GROUT	
			OVERDRILLED 3 FT	
3	0		BACKFILL	
7 CONTRACTOR'S OR LANDOWNER'S CERTIFICATION: This water well was plugged under my jurisdiction and was completed on (mo/day/yr) 03-09-06 and this record is true to the best of my knowledge and belief. Kansas Water Well Contractor's License No. 554 This Water Well Record was completed on (mo/day/yr) 04-14-06 under the business name of Woofter Pump & Well Inc.				
by (signature) _____ 				
INSTRUCTIONS: Please fill in blanks and circle the correct answers. Send three copies to Kansas Department of Health and Environment, Bureau of Water, 1000 S W Jackson St., Ste. 420, Topeka, Kansas 66620-0001. Telephone: 785-296-3565. Send one to Water Well Owner and retain one for your records.				