


1 LOCATION OF WATER WELL:	Fraction	Section Number	Township Number	Range Number
County: Stevens	SW 1/4 SW 1/4 NE 1/4	18	33	37

Distance and direction from nearest town or city street address of well if located within city?

2 Halliburton **City of Hugoton**
 RR#, St. Address, Box # **Northwest Keper** Board of Agriculture, Division of Water Resources
 City, State, ZIP Code : **Hugoton, Ks 67951** Application Number:

3 MARK WELL'S LOCATON WITH AN "X" IN SECTION BOX:

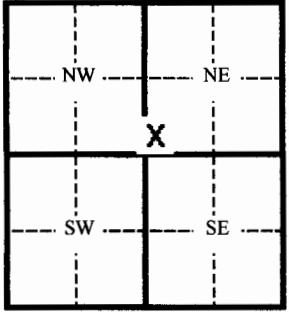

DEPTH OF WELL **130** ft.
 WELL'S STATIC WATER LEVEL **DRY** ft.
 WELL WAS USED AS:

1 Domestic	5 Public Water Supply	9 Dewatering
2 Irrigation	6 Oil Field Water Supply	<input checked="" type="checkbox"/> 10 Monitoring Well
3 Feedlot	7 Lawn and Garden (domestic)	11 Injection Well
4 Industrial	8 Air Conditioning	12 Other

Was a chemical/bacteriological sample submitted to Department? Yes ___ No
 If yes, mo/day/yr sample was submitted _____
 Water Well Disinfected: Yes ___ No

5 TYPE OF BLANK CASING USED:

1 Steel	3 RMP (SR)	5 Wrought	7 Fiberglass	9 Other (specify below)
<input checked="" type="checkbox"/> 2 PVC	4 ABC	6 Asbestos-Cement	8 Concrete Tile	OVERDRILLED 3 FT

Blank casing diameter **4** in. Was casing pulled? Yes ___ No ___ If yes, how much _____
 Casing height above or below land surface **- 3 FT** in.

6 GROUT PLUG MATERIAL: 1 Neat cement 2 Cement grout 3 Bentonite 4 Other _____

Grout Plug Intervals From **130** ft. to **3** ft. From _____ ft. to _____ ft. From _____ ft. to _____ ft.

What is the nearest source of possible contamination:

1 Septic tank	6 Seepage pit	11 Fuel storage	16 Other (specify below)
2 Sewer lines	7 Pit privy	12 Fertilizer storage	_____
3 Watertight sewer lines	8 Sewage lagoon	13 Insecticide storage	_____
4 Lateral lines	9 Feedyard	14 Abandoned water well	_____
5 Cess Pool	10 Livestock pens	15 Oil well/ Gas well	_____

Direction from well? _____ How many feet? _____

FROM	TO	CODE	PLUGGING MATERIALS
130	3		BENTONITE GROUT
			OVERDRILLED 3 FT
3	0		BACKFILL

7 on (mo/day/yr) **03-09-06** and this record is true to the best of my knowledge and belief. Kansas Water Well Contractor's License No. **554** This Water Well Record was completed on (mo/day/yr) **04-14-06** under the business name of **Woofter Pump & Well Inc.**
 by (signature) _____ *[Signature]*

INSTRUCTIONS: Please fill in blanks and circle the correct answers. Send three copies to Kansas Department of Health and Environment, Bureau of Water, 1000 S W Jackson St., Ste. 420, Topeka, Kansas 66620-0001. Telephone: 785-296-3565. Send one to Water Well Owner and retain one for your records.