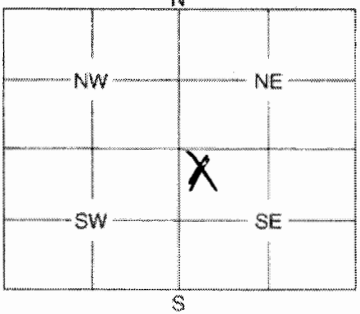


1	LOCATION OF WATER WELL: Stevens County:	Fraction NW NW SE	Section Number 16	Township Number 33S	Range Number 37W
---	--	-----------------------------	-----------------------------	-------------------------------	----------------------------

Distance and direction from nearest town or city street address of well if located within city?

700 Main, Hugoton, Kansas

2	WATER WELL OWNER: Taylor Food Mart #627 RR #, St. Address, Box #: P.O. Box 1049 City, State, ZIP Code: Hugoton, Ks 66610	Board of Agriculture, Division of Water Resources Application Number:
---	---	--

3	MARK WELL'S LOCATION WITH AN "X" IN SECTION BOX: 	4	DEPTH OF WELL 95 ft. WELL'S STATIC WATER LEVEL dry ft. WELL WAS USED AS: <table border="0"><tr><td>1 Domestic</td><td>5 Public Water Supply</td><td>9 Dewatering</td></tr><tr><td>2 Irrigation</td><td>6 Oil Field Water Supply</td><td>10 Monitoring Well</td></tr><tr><td>3 Feedlot</td><td>7 Domestic (Lawn & Garden)</td><td>11 Injection Well</td></tr><tr><td>4 Industrial</td><td>8 Air Conditioning</td><td>12 Other</td></tr></table> Was a chemical / bacteriological sample submitted to Department? Yes No X If yes, mo/day/yr sample was submitted Water Well Disinfected: Yes No X	1 Domestic	5 Public Water Supply	9 Dewatering	2 Irrigation	6 Oil Field Water Supply	10 Monitoring Well	3 Feedlot	7 Domestic (Lawn & Garden)	11 Injection Well	4 Industrial	8 Air Conditioning	12 Other
1 Domestic	5 Public Water Supply	9 Dewatering													
2 Irrigation	6 Oil Field Water Supply	10 Monitoring Well													
3 Feedlot	7 Domestic (Lawn & Garden)	11 Injection Well													
4 Industrial	8 Air Conditioning	12 Other													

5	TYPE OF BLANK CASING USED: <table border="0"><tr><td>1 Steel</td><td>3 RMP (SR)</td><td>5 Wrought</td><td>7 Fiberglass</td><td>9 Other (Specify below)</td></tr><tr><td>2 PVC</td><td>4 ABS</td><td>6 Asbestos-Cement</td><td>8 Concrete Tile</td><td></td></tr></table> Blank casing diameter 2 in. Was casing pulled? Yes No X If yes, how much Casing height above or below land surface in.	1 Steel	3 RMP (SR)	5 Wrought	7 Fiberglass	9 Other (Specify below)	2 PVC	4 ABS	6 Asbestos-Cement	8 Concrete Tile	
1 Steel	3 RMP (SR)	5 Wrought	7 Fiberglass	9 Other (Specify below)							
2 PVC	4 ABS	6 Asbestos-Cement	8 Concrete Tile								

6	GROUT PLUG MATERIAL: <table border="0"><tr><td>1 Neat cement</td><td>2 Cement grout</td><td>3 Bentonite</td><td>4 Other</td></tr></table> Grout Plug Intervals: From 3 95 ft. to 3 ft. From 2 3 ft. to 0 ft. From to ft. What is the nearest source of possible contamination: <table border="0"><tr><td>1 Septic tank</td><td>6 Seepage pit</td><td>11 Fuel storage</td></tr><tr><td>2 Sewer lines</td><td>7 Pit privy</td><td>12 Fertilizer storage</td></tr><tr><td>3 Watertight sewer lines</td><td>8 Sewage lagoon</td><td>13 Insecticide storage</td></tr><tr><td>4 Lateral lines</td><td>9 Feedyard</td><td>14 Abandoned water well</td></tr><tr><td>5 Cess pool</td><td>10 Livestock pens</td><td>15 Oil well/Gas well</td></tr></table> Direction from well? How many feet? 16 Other (specify below) cont. sink	1 Neat cement	2 Cement grout	3 Bentonite	4 Other	1 Septic tank	6 Seepage pit	11 Fuel storage	2 Sewer lines	7 Pit privy	12 Fertilizer storage	3 Watertight sewer lines	8 Sewage lagoon	13 Insecticide storage	4 Lateral lines	9 Feedyard	14 Abandoned water well	5 Cess pool	10 Livestock pens	15 Oil well/Gas well
1 Neat cement	2 Cement grout	3 Bentonite	4 Other																	
1 Septic tank	6 Seepage pit	11 Fuel storage																		
2 Sewer lines	7 Pit privy	12 Fertilizer storage																		
3 Watertight sewer lines	8 Sewage lagoon	13 Insecticide storage																		
4 Lateral lines	9 Feedyard	14 Abandoned water well																		
5 Cess pool	10 Livestock pens	15 Oil well/Gas well																		

FROM	TO	PLUGGING MATERIALS
95	3	Bentonite grout
3	0	Concrete

7	CONTRACTOR'S OF LANDOWNER'S CERTIFICATION: This water well was plugged under my jurisdiction and was completed on (mo/day/year) 10/11/06 and this record is true to the best of my knowledge and belief. Kansas Water Well Contractor's License No. 585 This Water Well Record was completed on (mo/day/year) 11/11/06 under the business name of Associated Environmental, Inc. by (signature) B. Johnson
---	--

INSTRUCTIONS: Use typewriter or ball point pen. Please press firmly and print clearly. Please fill in blanks, underline or circle the correct answers. Send top three copies to Kansas Department of Health and Environment, Bureau of Water, Geology Section, 1000 SW Jackson St., Ste. 420, Topeka, Kansas 66612-1367. Telephone: 785/296-5522. Send one to Water Well Owner and retain one for your records.