


<b>1</b> LOCATION OF WATER WELL:	Fraction	Section Number	Township Number	Range Number
County: <b>Stevens</b>	<b>SW 1/4 SW 1/4 NE 1/4</b>	<b>16</b>	<b>33</b>	<b>37w</b>

Distance and direction from nearest town or city street address of well if located within city?

**2** WATER WELL OWNER: **City of Hugoton**  
 RR#, St. Address, Box # **112 5<sup>th</sup> St**  
 City, State, ZIP Code : **Hugoton, KS 67951**

Board of Agriculture, Division of Water Resources  
Application Number:

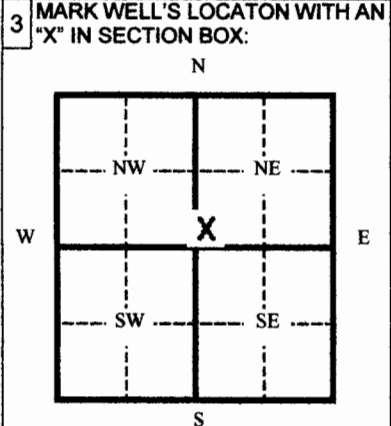

**4** DEPTH OF WELL ..... **100.00** ..... ft.  
 WELL'S STATIC WATER LEVEL ..... **NA** ..... ft.  
 WELL WAS USED AS:

1 Domestic	5 Public Water Supply	9 Dewatering
2 Irrigation	6 Oil Field Water Supply	10 Monitoring Well
3 Feedlot	7 Lawn and Garden (domestic)	11 Injection Well
4 Industrial	8 Air Conditioning	<b>12 Other <u>Air Sparge</u></b>

Was a chemical/bacteriological sample submitted to Department? Yes \_\_\_\_\_ No **X**  
 If yes, mo/day/yr sample was submitted \_\_\_\_\_  
 Water Well Disinfected: Yes \_\_\_\_\_ No **X**

**5** TYPE OF BLANK CASING USED:

1 Steel	3 RMP (SR)	5 Wrought	7 Fiberglass	9 Other (specify below)
<b>2 PVC</b>	4 ABC	6 Asbestos-Cement	8 Concrete Tile	<b>Overdrilled 3 ft.</b>

Blank casing diameter ..... **2** ..... in. Was casing pulled? Yes \_\_\_\_\_ No **X** If yes, how much \_\_\_\_\_  
 Casing height above or below land surface ..... **-3 Ft** ..... in.

**6** GROUT PLUG MATERIAL: 1 Neat cement 2 Cement grout 3 Bentonite 4 Other \_\_\_\_\_

Grout Plug Intervals From **100.00** ft. to **3** ft. From \_\_\_\_\_ ft. to \_\_\_\_\_ ft. From \_\_\_\_\_ ft. to \_\_\_\_\_ ft.

What is the nearest source of possible contamination:

1 Septic tank	6 Seepage pit	11 Fuel storage	16 Other (specify below)
2 Sewer lines	7 Pit privy	12 Fertilizer storage	<i>None</i>
3 Watertight sewer lines	8 Sewage lagoon	13 Insecticide storage	
4 Lateral lines	9 Feedyard	14 Abandoned water well	
5 Cess Pool	10 Livestock pens	15 Oil well/ Gas well	

Direction from well? \_\_\_\_\_ How many feet? \_\_\_\_\_

FROM	TO	CODE	PLUGGING MATERIALS
<b>100.00</b>	<b>3</b>		<b>Bentonite Grout</b>
			<b>Overdrilled 3 ft.</b>
<b>3</b>	<b>0</b>		<b>Backfill</b>

**7** CONTRACTOR'S OR LANDOWNER'S CERTIFICATION: This water well was plugged under my jurisdiction and was completed on (mo/day/yr) **3-8-06** and this record is true to the best of my knowledge and belief. Kansas Water Well Contractor's License No. **554** This Water Well Record was completed on (mo/day/yr) **2-7-07** under the business name of **Woofer Pump & Well Inc.**

by (signature) \_\_\_\_\_

INSTRUCTIONS: Please fill in blanks and circle the correct answers. Send three copies to Kansas Department of Health and Environment, Bureau of Water, 1000 S W Jackson St., Ste. 420, Topeka, Kansas 66620-0001. Telephone: 785-296-3565. Send one to Water Well Owner and retain one for your records.