

Corrected


mw-1R

WATER WELL PLUGGING RECORD Form WWC-5P KSA 82a-1212 ID NO.

1 LOCATION OF WATER WELL: County: Stevens Fraction NW 1/4 NW 1/4 SE 1/4 Section Number 16 Township Number 33S Range Number 37W

Distance and direction from nearest town or city street address of well if located within city? 700 S. Main, Hugoton, Kansas

2 WATER WELL OWNER: Taylor Food Mart #627 RR#, St. Address, Box #: P.O. Box 1049 City, State ZIP Code: Hugoton, KS 67951 Global Positioning Systems (decimal degrees, min. of 4 digits) Latitude: Longitude: Elevation: Datum: Data Collection Method:

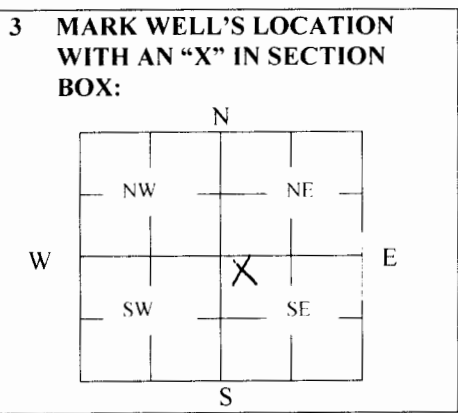

3 MARK WELL'S LOCATION WITH AN "X" IN SECTION BOX: 4 DEPTH OF WELL 130.38 ft. WELL'S STATIC WATER LEVEL 111.00 ft. WELL WAS USED AS: 1 Domestic 2 Irrigation 3 Feedlot 4 Industrial 5 Public Water Supply 6 Oil Field Water Supply 7 Domestic (Lawn & Garden) 8 Air Conditioning 9 Dewatering 10 Monitoring 11 Injection Well 12 Other Was a chemical/bacteriological sample submitted to Department? Yes No X

5 TYPE OF BLANK CASING USED: 1 Steel 2 PVC 3 RMP (SR) 4 ABS 5 Wrought 6 Asbestos-Cement 7 Fiberglass 8 Concrete Tile 9 Other (Specify below) Blank casing diameter 4 in. Was casing pulled? Yes X No If yes, how much 3' Casing height above or below land surface in.

6 GROUT PLUG MATERIAL: 1 Neat cement 2 Cement grout 3 Bentonite 4 Other chlor. sand Grout Plug Intervals: From 130.38 ft. to 111.00 ft., From 111 ft. to 3 ft., From 3 to .5 ft. What is the nearest source of possible contamination: 1 Septic tank 2 Sewer lines 3 Watertight sewer lines 4 Lateral lines 5 Cess pool 6 Seepage pit 7 Pit privy 8 Sewage lagoon 9 Feedyard 10 Livestock pens 11 Fuel Storage 12 Fertilizer storage 13 Insecticide storage 14 Abandoned water well 15 Oil well/Gas well 16 Other (specify below) cont. site Direction from well? How many feet? 5-0-concrete

FROM	TO	PLUGGING MATERIALS	FROM	TO	PLUGGING MATERIALS
130.38	111.00	chlorinated sand			
111.00	3.00	Bentonite			
3.00	.5	surface soil			
.5	0	concrete			

7 CONTRACTOR'S OR LANDOWNER'S CERTIFICATION: This water well was plugged under my jurisdiction and was completed on (mo/day/year) 03/18/09 and this record is true to the best of my knowledge and belief. Kansas Water Well Contractor's License No. 585 This Water Well Record was completed on (mo/day/year) 04/1/09 under the business name of Associated Environmental by (signature) Bradley Johnson

INSTRUCTIONS: Use typewriter or ballpoint pen. Please press firmly and print clearly. Please fill in blanks, underline or circle the correct answers. Send top three copies to Kansas Department of Health and Environment, Bureau of Water, Geology Section, 1000 SW Jackson St., Ste. 420, Topeka, Kansas 66612-1367. Telephone: 785/296-5522. Send one to Water Well Owner and retain one for your records. Visit us at http://www.kdheks.gov/waterwell/index.html.