

Corrected

mw-4R

WATER WELL PLUGGING RECORD Form WWC-5P

KSA 82a-1212

ID NO.

1 LOCATION OF WATER WELL: County: Stevens	Fraction NW 1/4 NW 1/4 SE 1/4	Section Number 16	Township Number 33S	Range Number 37W
--	----------------------------------	----------------------	------------------------	---------------------

Distance and direction from nearest town or city street address of well if located within city?
700 S. Main, Hugoton, Kansas


2 WATER WELL OWNER:

Taylor Food Mart #627
RR#, St. Address, Box #:
P.O. Box 1049
City, State ZIP Code:
Hugoton, KS 67951

Global Positioning Systems (decimal degrees, min. of 4 digits)

Latitude: _____
Longitude: _____
Elevation: _____
Datum: _____
Data Collection Method: _____

3 MARK WELL'S LOCATION WITH AN "X" IN SECTION BOX:

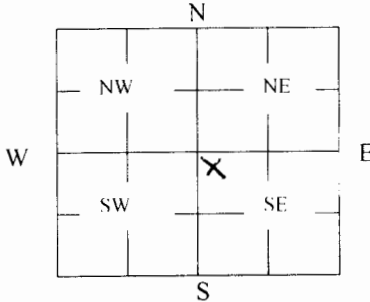

4 DEPTH OF WELL 129.60 ft.

WELL'S STATIC WATER LEVEL 110.34 ft

WELL WAS USED AS:

- | | | |
|--------------|----------------------------|-------------------|
| 1 Domestic | 5 Public Water Supply | 9 Dewatering |
| 2 Irrigation | 6 Oil Field Water Supply | 10 Monitoring |
| 3 Feedlot | 7 Domestic (Lawn & Garden) | 11 Injection Well |
| 4 Industrial | 8 Air Conditioning | 12 Other _____ |

Was a chemical/bacteriological sample submitted to Department? Yes _____ No

5 TYPE OF BLANK CASING USED:

- | | | | | |
|---------|------------|-------------------|-----------------|-------------------------|
| 1 Steel | 3 RMP (SR) | 5 Wrought | 7 Fiberglass | 9 Other (Specify below) |
| 2 PVC | 4 ABS | 6 Asbestos-Cement | 8 Concrete Tile | |

Blank casing diameter 4 in. Was casing pulled? Yes No _____ If yes, how much 3'
Casing height above or below land surface _____ in.

6 GROUT PLUG MATERIAL:

- | | | | |
|---------------|----------------|-------------|---------------|
| 1 Neat cement | 2 Cement grout | 3 Bentonite | 4 Other _____ |
|---------------|----------------|-------------|---------------|

Grout Plug Intervals: From 129.6 ft. to 110.34 ft., From 110.34 ft. to 3 ft., From 3 to .5 ft.
chlorinated sand *Bentonite* *surface silts/clays*

What is the nearest source of possible contamination:

- | | | | |
|--------------------------|-------------------|-------------------------|----------------------------|
| 1 Septic tank | 6 Seepage pit | 11 Fuel Storage | 16 Other (specify below) |
| 2 Sewer lines | 7 Pit privy | 12 Fertilizer storage | <u>cont. site</u> |
| 3 Watertight sewer lines | 8 Sewage lagoon | 13 Insecticide storage | |
| 4 Lateral lines | 9 Feedyard | 14 Abandoned water well | Direction from well? _____ |
| 5 Cess pool | 10 Livestock pens | 15 Oil well/Gas well | How many feet? _____ |

FROM	TO	PLUGGING MATERIALS	FROM	TO	PLUGGING MATERIALS
129.6	110.34	chlorinated sand			
110.34	3	Bentonite			
3	.5	surface silts/clays			
.5	0	concrete			

7 CONTRACTOR'S OR LANDOWNER'S CERTIFICATION: This water well was plugged under my jurisdiction and was completed on (mo/day/year) 03/18/09 and this record is true to the best of my knowledge and belief. Kansas Water Well Contractor's License No. 585. This Water Well Record was completed on (mo/day/year) 04/1/09 under the business name of Associated Environmental by (signature) [Signature]

INSTRUCTIONS: Use typewriter or ballpoint pen. Please press firmly and print clearly. Please fill in blanks, underline or circle the correct answers. Send top three copies to Kansas Department of Health and Environment, Bureau of Water, Geology Section, 1000 SW Jackson St., Ste. 420, Topeka, Kansas 66612-1367. Telephone: 785/296-5522. Send one to Water Well Owner and retain one for your records. Visit us at <http://www.kdheks.gov/waterwell/index.html>.