

WATER WELL RECORD Form WWC-5


Original Record Correction Change in Well Use

Division of Water Resources App. No.

Well ID

1 LOCATION OF WATER WELL: County: Stevens Fraction: 1/4 NW 1/4 NE 27 Section Number: 27 Township Number: T 33 S Range Number: R 37 E 14W

2 WELL OWNER: Last Name: Gibson First: Justin Street or Rural Address where well is located (if unknown, distance and direction from nearest town or intersection): If at owner's address, check here:
 Business: Address: 824 N. Jackson St
 Address: City: Huzoton State: KS ZIP: 67951

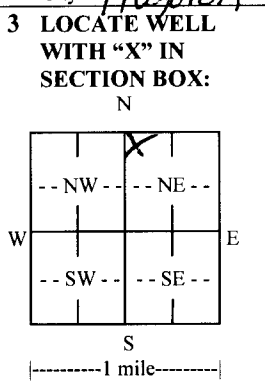

4 DEPTH OF COMPLETED WELL: 575 ft.
 Depth(s) Groundwater Encountered: 1) ft.
 2) ft. 3) ft., or 4) Dry Well
 WELL'S STATIC WATER LEVEL: ft.
 below land surface, measured on (mo-day-yr).....
 above land surface, measured on (mo-day-yr).....
 Pump test data: Well water was ft.
 after..... hours pumping gpm
 Well water was ft.
 after..... hours pumping gpm
 Estimated Yield:gpm
 Bore Hole Diameter: in. to ft. and
 in. to ft.

5 Latitude: (decimal degrees)
Longitude: (decimal degrees)
 Datum: WGS 84 NAD 83 NAD 27
Source for Latitude/Longitude:
 GPS (unit make/model:)
 (WAAS enabled? Yes No)
 Land Survey Topographic Map
 Online Mapper:

6 Elevation:ft. Ground Level TOC
Source: Land Survey GPS Topographic Map
 Other

7 WELL WATER TO BE USED AS:

1. Domestic: Household Lawn & Garden Livestock
 2. Irrigation
 3. Feedlot
 4. Industrial

5. Public Water Supply: well ID

6. Dewatering: how many wells?

7. Aquifer Recharge: well ID

8. Monitoring: well ID

9. Environmental Remediation: well ID

Air Sparge Soil Vapor Extraction
 Recovery Injection

10. Oil Field Water Supply: lease

11. Test Hole: well ID

Cased Uncased Geotechnical

12. Geothermal: how many bores?

a) Closed Loop Horizontal Vertical
 b) Open Loop Surface Discharge Inj. of Water

13. Other (specify):

Was a chemical/bacteriological sample submitted to KDHE? Yes No If yes, date sample was submitted:

Water well disinfected? Yes No

8 TYPE OF CASING USED: Steel PVC Other CASING JOINTS: Glued Clamped Welded Threaded
 Casing diameter 5 in. to 5.75 ft., Diameter in. to ft., Diameter in. to ft.
 Casing height above land surface 12 in. Weight lbs./ft. Wall thickness or gauge No. #100.....

TYPE OF SCREEN OR PERFORATION MATERIAL:
 Steel Stainless Steel Fiberglass PVC Other (Specify)
 Brass Galvanized Steel Concrete tile None used (open hole)

SCREEN OR PERFORATION OPENINGS ARE:
 Continuous Slot Mill Slot Gauze Wrapped Torch Cut Drilled Holes Other (Specify)
 Louvered Shutter Key Punched Wire Wrapped Saw Cut None (Open Hole)

SCREEN-PERFORATED INTERVALS: From 575 ft. to 575 ft., From ft. to ft., From ft. to ft.
GRAVEL PACK INTERVALS: From 200 ft. to 575 ft., From ft. to ft., From ft. to ft.

9 GROUT MATERIAL: Neat cement Cement grout Bentonite Other
 Grout Intervals: From 5 ft. to 25 ft., From 195 ft. to 200 ft., From ft. to ft.

Nearest source of possible contamination:
 Septic Tank Lateral Lines Pit Privy Livestock Pens Insecticide Storage
 Sewer Lines Cess Pool Sewage Lagoon Fuel Storage Abandoned Water Well
 Watertight Sewer Lines Seepage Pit Feedyard Fertilizer Storage Oil Well/Gas Well
 Other (Specify)

Direction from well? Distance from well? ft.

| 10 FROM | TO | LITHOLOGIC LOG | FROM | TO | LITHO. LOG (cont.) or PLUGGING INTERVALS |
|---------|-----|---------------------------|--------|-----|--|
| 0 | 4 | Topsoil | 258 | 360 | Red Clay & Fine Sand streaks |
| 4 | 6 | Gray Clay | 360 | 480 | Red & Pink Sand |
| 6 | 77 | Sandy Clay & Sand Layers | 480 | 548 | Clay & Very Fine Sand streaks |
| 77 | 79 | Rocks | | | with Rock layers |
| 79 | 101 | Sandy Clay & Sand Layers | 548 | 575 | Med. Fine Sand |
| 101 | 106 | Caliche | 575 | 580 | Red bed |
| 106 | 190 | Clay & Sandstone Layers | Notes: | | |
| 190 | 217 | Sandy Clay & Sand streaks | | | |
| 217 | 258 | Tan Clay & Mixed Sand | | | |

11 CONTRACTOR'S OR LANDOWNER'S CERTIFICATION: This water well was constructed, reconstructed, or plugged under my jurisdiction and was completed on (mo-day-year) 4-2-14 and this record is true to the best of my knowledge and belief.
 Kansas Water Well Contractor's License No. 805 This Water Well Record was completed on (mo-day-year) 4-7-14 under the business name of SOUTHWEST WINDMILL