

WATER WELL PLUGGING RECORD Form WWC-5P

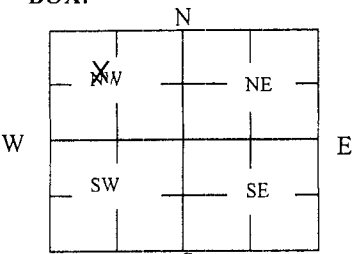
KSA 82a-1212

ID NO.

1 LOCATION OF WATER WELL: County: Stevens	Fraction ¼ SE ¼ NW ¼ NW ¼	Section Number 16	Township Number T 33 S	Range Number 37 <input type="checkbox"/> E <input checked="" type="checkbox"/> W
---	------------------------------	----------------------	---------------------------	---

Street/Rural Address of Well Location; if unknown, distance & direction from nearest town or intersection: If at owner's address, check here <input type="checkbox"/> 210 S. Polk St., Hugoton, KS 67951 (listed as Northwest and Harper on original WWC-5)	Global Positioning Systems (GPS) information: Latitude: _____ (in decimal degrees) Longitude: _____ (in decimal degrees) Elevation: _____ Horizontal Datum: <input type="checkbox"/> WGS84, <input type="checkbox"/> NAD83, <input type="checkbox"/> NAD27 Collection Method: <input type="checkbox"/> GPS unit (Make/Model: _____) <input type="checkbox"/> Digital Map/Photo, <input type="checkbox"/> Topographic Map, <input type="checkbox"/> Land Survey Est. Accuracy: <input type="checkbox"/> < 3 m, <input type="checkbox"/> 3-5 m, <input type="checkbox"/> 5-15 m, <input type="checkbox"/> > 15 m
--	---

2 WATER WELL OWNER: Halliburton Energy Services RR#, St. Address, Box #: 3000 N Sam Houston Pkwy E City, State ZIP Code: Houston, TX 77032	
---	--

3 MARK WELL'S LOCATION WITH AN "X" IN SECTION BOX: 	4 DEPTH OF WELL <u>151</u> ft. WELL'S STATIC WATER LEVEL <u>DRY</u> ft. WELL WAS USED AS: <table style="width: 100%;"> <tr> <td><input type="checkbox"/> Domestic</td> <td><input type="checkbox"/> Public Water Supply</td> <td><input type="checkbox"/> Dewatering</td> </tr> <tr> <td><input type="checkbox"/> Irrigation</td> <td><input type="checkbox"/> Oil Field Water Supply</td> <td><input checked="" type="checkbox"/> Monitoring MW-6R</td> </tr> <tr> <td><input type="checkbox"/> Feedlot</td> <td><input type="checkbox"/> Domestic (Lawn & Garden)</td> <td><input type="checkbox"/> Injection Well</td> </tr> <tr> <td><input type="checkbox"/> Industrial</td> <td><input type="checkbox"/> Air Conditioning</td> <td><input type="checkbox"/> Other _____</td> </tr> </table> Was a chemical/bacteriological sample submitted to Department? Yes <input type="checkbox"/> No <input checked="" type="checkbox"/>	<input type="checkbox"/> Domestic	<input type="checkbox"/> Public Water Supply	<input type="checkbox"/> Dewatering	<input type="checkbox"/> Irrigation	<input type="checkbox"/> Oil Field Water Supply	<input checked="" type="checkbox"/> Monitoring MW-6R	<input 

5 TYPE OF BLANK CASING USED:

<input type="checkbox"/> Steel	<input type="checkbox"/> RMP (SR)	<input type="checkbox"/> Wrought	<input type="checkbox"/> Fiberglass	<input type="checkbox"/> Other (Specify below) _____
<input checked="" type="checkbox"/> PVC	<input type="checkbox"/> ABS	<input type="checkbox"/> Asbestos-Cement	<input type="checkbox"/> Concrete Tile	

Blank casing diameter 4 in. Was casing pulled? Yes No If yes, how much 3'
 Casing height above or below land surface - 36 in.

6 GROUT PLUG MATERIAL: Neat cement Cement grout Bentonite Other _____

Grout Plug Intervals: From 3 ft. to 151 ft., From _____ ft. to _____ ft., From _____ ft. to _____ ft.

What is the nearest source of possible contamination:

<input type="checkbox"/> Septic tank	<input type="checkbox"/> Seepage pit	<input type="checkbox"/> Fuel storage	<input type="checkbox"/> Other (specify below) _____
<input type="checkbox"/> Sewer lines	<input type="checkbox"/> Pit privy	<input type="checkbox"/> Fertilizer storage	
<input type="checkbox"/> Watertight sewer lines	<input type="checkbox"/> Sewage lagoon	<input type="checkbox"/> Insecticide storage	
<input type="checkbox"/> Lateral lines	<input type="checkbox"/> Feedyard	<input type="checkbox"/> Abandoned water well	Direction from well? _____
<input type="checkbox"/> Cess pool	<input type="checkbox"/> Livestock pens	<input type="checkbox"/> Oil well/Gas well	How many feet? _____

FROM	TO	PLUGGING MATERIALS	FROM	TO	PLUGGING MATERIALS
0	0.5	Concrete			
0.5	3	Native soil			
3	151	Bentonite grout			
					NOTE:
					Section fraction for MW-6R listed as
					SE SE NW with address of
					Northwest & Harper on original WWC5

7 CONTRACTOR'S OR LANDOWNER'S CERTIFICATION: This water well was plugged under my jurisdiction and was completed on (mo/day/year) 2/12/16 and this record is true to the best of my knowledge and belief. Kansas Water Well Contractor's License No. 881. This Water Well Record was completed on (mo/day/year) 4/8/16 under the business name of Woofert Pump and Well by (signature) [Signature]

Send one white copy to Kansas Department of Health & Environment, Geology Section, 1000 SW Jackson Street, Ste. 420, Topeka, KS 66612-1367. Send one copy to WATER WELL OWNER and retain one for your records.
 Visit us at <http://www.kdheks.gov/waterwell/index.html> Telephone 785-296-5524.



MILCO

Environmental Services, Inc.

320 West 4th Street
Colby, KS 67701
Tel: 785-460-1956
Fax: 785-460-4220
www.milcoinc.com

April 29, 2016

Kansas Department of Health and Environment
Bureau of Water - GWTS
1000 SW Jackson St, Ste 420
Topeka, KS 66612-1367

RE: Hoxie Stop 2 Shop
KDHE Project Code U6-090-14793
MILCO Project No. M259-P8-01

City of Hays Service Center
KDHE Project Code U6-026-00771
MILCO Project No. M273-G1-01

Halliburton Energy Services
KDHE Project Code U1-095-11019
MILCO Project No. M435-P2-02

Dear Sir or Madam:

Please find enclosed five (5) Water Well Records for the Hoxie Stop 2 Shop site. The wells were constructed by RMD Drilling and Well Service on April 1 and April 4, 2016.

Please find enclosed eight (8) Water Well Plugging Records for the City of Hays Service Center site. The wells were abandoned by MILCO on April 1, 2016.

Please find enclosed three (3) Water Well Records and four (4) Water Well Plugging Records for the Halliburton Energy Services site. The wells were constructed and plugged by Woofter Pump and Well on February 12, 2016.

A check for \$40.00 is enclosed for the 5 Hoxie Stop 2 Shop and 3 Halliburton Energy WWC5s. If you need any additional information, please don't hesitate to contact us.

Respectfully submitted,
MILCO Environmental Services, Inc.



Leah MacNeill

Enclosures

RECEIVED
MAY 09 2016
BUREAU OF WATER