


1 LOCATION OF WATER WELL: Fraction NW 1/4 SE 1/4 SW 1/4 Section Number 2 Township Number T 33 S Range Number R 37 **EW**

Distance and direction from nearest town or city street address of well if located within city?  
 1 Mile North and 1 1/2 Miles ~~West~~ East of Hugoton, Kansas

2 WATER WELL OWNER: Matt Wing  
 RR#, St. Address, Box #: 1107 S. ADAMS Board of Agriculture, Division of Water Resources  
 City, State, ZIP Code: Hugoton, KS 67951 Application Number: ---

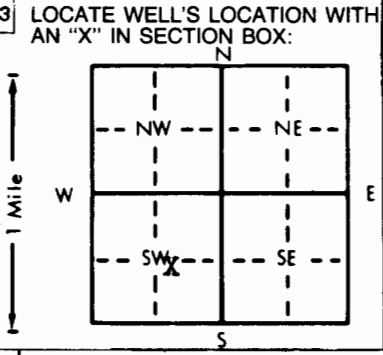

4 DEPTH OF COMPLETED WELL: 250 ft. ELEVATION: Slope  
 Depth(s) Groundwater Encountered 1. Not ~~230~~able ft. 2. ft. 3. ft.  
 WELL'S STATIC WATER LEVEL: 170 ft. below land surface measured on mo/day/yr October 25, 1989  
 Pump test data: Well water was ft. after hours pumping gpm  
 Est. Yield: 15 gpm; Well water was ft. after hours pumping gpm  
 Bore Hole Diameter: 10 in. to 250 ft., and in. to ft.  
 WELL WATER TO BE USED AS:  
 5 Public water supply 8 Air conditioning 11 Injection well  
 XX Domestic 3 Feedlot 6 Oil field water supply 9 Dewatering 12 Other (Specify below)  
 2 Irrigation 4 Industrial 7 Lawn and garden only 10 Monitoring well  
 Was a chemical/bacteriological sample submitted to Department? Yes No XX; If yes, mo/day/yr sample was submitted  
 Water Well Disinfected? Yes XX No

5 TYPE OF BLANK CASING USED:  
 1 Steel 3 RMP (SR) 5 Wrought iron 8 Concrete tile CASING JOINTS: Glued XX Clamped  
 XX PVC 4 ABS 6 Asbestos-Cement 9 Other (specify below) Welded  
 7 Fiberglass Threaded  
 Blank casing diameter: 5 in. to 230 ft., Dia in. to ft., Dia in. to ft.  
 Casing height above land surface: 20 in., weight 2.8 lbs./ft. Wall thickness or gauge No. 265  
 TYPE OF SCREEN OR PERFORATION MATERIAL:  
 1 Steel 3 Stainless steel 5 Fiberglass 8 RMP (SR) 10 Asbestos-cement  
 2 Brass 4 Galvanized steel 6 Concrete tile 9 ABS 11 Other (specify)  
 12 None used (open hole)  
 SCREEN OR PERFORATION OPENINGS ARE:  
 1 Continuous slot 3 Mill slot 5 Gauzed wrapped XX Saw cut 11 None (open hole)  
 2 Louvered shutter 4 Key punched 6 Wire wrapped 9 Drilled holes  
 7 Torch cut 10 Other (specify)  
 SCREEN-PERFORATED INTERVALS: From 230 ft. to 250 ft., From ft. to ft.  
 From ft. to ft., From ft. to ft.  
 GRAVEL PACK INTERVALS: From 40 ft. to 250 ft., From ft. to ft.  
 From ft. to ft., From ft. to ft.

6 GROUT MATERIAL: 1 Neat cement 2 Cement grout 3 Bentonite XX Other Baroid Hole Plug  
 Grout Intervals: From 0 ft. to 40 ft. From ft. to ft., From ft. to ft.  
 What is the nearest source of possible contamination: NONE  
 1 Septic tank 4 Lateral lines 7 Pit privy 10 Livestock pens 14 Abandoned water well  
 2 Sewer lines 5 Cess pool 8 Sewage lagoon 11 Fuel storage 15 Oil well/Gas well  
 3 Watertight sewer lines 6 Seepage pit 9 Feedyard 12 Fertilizer storage 16 Other (specify below)  
 13 Insecticide storage  
 Direction from well? How many feet?

FROM	TO	LITHOLOGIC LOG	FROM	TO	PLUGGING INTERVALS
0	2	Topsoil			
2	26	Fine Sand			
26	231	Clay			
231	240	Med. Sand & Gravel			
240	250	Blue Clay			
250	290	Blue Clay			
290	400	Red Bed			

7 CONTRACTOR'S OR LANDOWNER'S CERTIFICATION: This water well was (1) constructed, (2) reconstructed, or (3) plugged under my jurisdiction and was completed on (mo/day/year) October 26, 1989 and this record is true to the best of my knowledge and belief. Kansas Water Well Contractor's License No. 252 This Water Well Record was completed on (mo/day/yr) December 11, 1989 under the business name of Friesen Windmill & Supply Inc. by (signature)

120802068-1

OFFICE USE ONLY  
T  
R  
E/W  
SEC.  
1/4  
1/4  
1/4