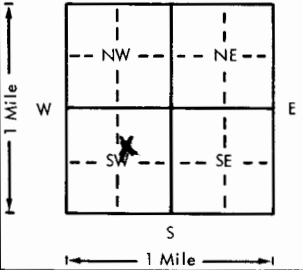


USE TYPEWRITER OR BALL  
POINT PEN-PRESS FIRMLY,  
PRINT CLEARLY.

WATER WELL RECORD  
KSA 82a-1201-1215

Kansas Department of Health and  
Environment-Division of Environment  
(Water well Contractors)  
Topeka, Kansas 66620

1. Location of well:		County <b>STEVENS</b>	Fraction <b>SW 1/4 NE 1/4 SW 1/4</b>	Section number <b>28</b>	Township number <b>T 33 S R 37 E</b>	Range number <b>37</b>
2. Distance and direction from nearest town or city: <b>1-3/4 miles south of Hugoton, KS.</b>				3. Owner of well: <b>DONALD KNIER</b> R.R. or street: <b>Box 109</b> City, state, zip code: <b>Hugoton, KS 65951</b>		
4. Locate with "X" in section below:		Sketch map:		6. Bore hole dia. <b>26</b> in. Completion date <b>5-11-82</b> Well depth <b>557</b> ft.		
				7. <input type="checkbox"/> Cable tool <input checked="" type="checkbox"/> Rotary <input type="checkbox"/> Driven <input type="checkbox"/> Dug <input type="checkbox"/> Hollow rod <input type="checkbox"/> Jetted <input type="checkbox"/> Bored <input type="checkbox"/> Reverse rotary		
5. Type and color of material		From		To		8. Use: <input type="checkbox"/> Domestic <input type="checkbox"/> Public supply <input type="checkbox"/> Industry <input checked="" type="checkbox"/> Irrigation <input type="checkbox"/> Air conditioning <input type="checkbox"/> Stock <input type="checkbox"/> Lawn <input type="checkbox"/> Oil field water <input type="checkbox"/> Other
Top soil		01		0		9. Casing: Material <b>Steel</b> Height: Above or below Threaded <input type="checkbox"/> Welded <input checked="" type="checkbox"/> Surface <b>12</b> in. RMP <input type="checkbox"/> PVC <input type="checkbox"/> Weight <b>42.5</b> lbs./ft. Dia. <b>16</b> in. to <b>557</b> ft. depth Wall Thickness: inches or Dia. <input type="checkbox"/> in. to <input type="checkbox"/> ft. depth gage No. <b>.250</b>
Med coarse sand & clay		04		220		10. Screen: Manufacturer's name Type <b>Steel</b> Dia. <b>16"</b> Slot/gauze <b>1/8</b> Length <b>3</b> Set between <b>525</b> ft. and <b>555</b> ft. <b>237-525</b> ft. and <b>555-557</b> ft. Gravel pack? <b>yes</b> Size range of material <b>1/8-1/4</b>
Red & blue clay w/fine sand		01		240		11. Static water level: <b>135</b> mo./day/yr. ft. below land surface Date <b>5-11-82</b>
Brown clay & red sand		04		320		12. Pumping level below land surfaces: <b>N/A</b> ft. after hrs. pumping g.p.m. ft. after hrs. pumping g.p.m. Estimated maximum yield g.p.m.
Fine sand & clay		04		380		13. Water sample submitted: mo./day/yr. Yes <input checked="" type="checkbox"/> No <input type="checkbox"/> Date
Med sand & clay stk.		04		400		14. Well head completion: <b>N/A</b> Pitless adapter <input type="checkbox"/> Inches above grade
Med coarse sand		08		540		15. Well grouted? <b>yes</b> With <input checked="" type="checkbox"/> Neat cement <input type="checkbox"/> Bentonite <input type="checkbox"/> Concrete Depth: From <b>0</b> ft. to <b>10</b> ft.
Red clay		01		557		16. Nearest source of possible contamination: ft. Direction Type <input checked="" type="checkbox"/> Well disinfected upon completion? Yes <input checked="" type="checkbox"/> No <input type="checkbox"/>
						17. Pump: <input checked="" type="checkbox"/> Not installed Manufacturer's name Model number HP Volts Length of drop pipe ft. capacity g.p.m. Type: <input type="checkbox"/> Submersible <input type="checkbox"/> Turbine <input type="checkbox"/> Jet <input type="checkbox"/> Reciprocating <input type="checkbox"/> Centrifugal <input type="checkbox"/> Other
						18. Elevation:
						19. Remarks:
						20. Water well contractor's certification: This well was drilled under my jurisdiction and this report is true to the best of my knowledge and belief. <b>KTM DRILLING, INC.</b> 225 Business name License No. Address <b>Box 1385, Guymon, OK</b> Signed <b>[Signature]</b> Date <b>7/13/82</b> Authorized representative