

1 LOCATION OF WATER WELL: County: Stevens Fraction: SW 1/4 SW 1/4 NW 1/4 Section Number: 21 Township Number: T 33 S Range Number: R 38 EW

Distance and direction from nearest town or city street address of well if located within city?

From Hugoton - 6 mile West - 1/2 mile South

2 WATER WELL OWNER: Keith Farror


RR#, St. Address, Box # HCO

City, State, ZIP Code Hugoton, KS 67551

Board of Agriculture, Division of Water Resources

Application Number:

3 LOCATE WELL'S LOCATION WITH AN "X" IN SECTION BOX:

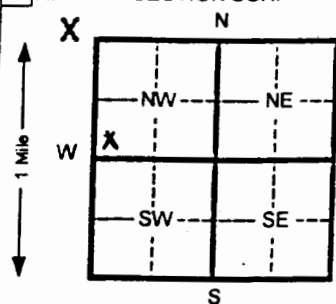

4 DEPTH OF COMPLETED WELL

430 ft. ELEVATION:

Depth(s) Groundwater Encountered 1 _____ ft. 2 _____ ft. 3 _____ ft.

WELL'S STATIC WATER LEVEL 215 ft. below land surface measured on mo/day/yr

Pump test data: Well water was _____ ft. after _____ hours pumping _____ gpm

Est. Yield _____ gpm: Well water was _____ ft. after _____ hours pumping _____ gpm

Bore Hole Diameter _____ in. to _____ ft. and _____ in. to _____ ft.

WELL WATER TO BE USED AS: 5 Public water supply 8 Air conditioning 11 Injection well

1 Domestic 3 Feed lot 6 Oil field water supply 9 Dewatering 12 Other (Specify below)

2 Irrigation 4 Industrial 7 Lawn and garden (domestic) 10 Monitoring well

Was a chemical/bacteriological sample submitted to Department? Yes _____ No ☒ If yes, mo/day/yr sample was submitted

Water Well Disinfected? Yes ☒ No

5 TYPE OF BLANK CASING USED:

1 Steel

3 RMP (SR)

5 Wrought Iron

8 Concrete tile

CASING JOINTS: Glued _____ Clamped _____

2 PVC

4 ABS

6 Asbestos-Cement

9 Other (specify below)

Welded _____

7 Fiberglass

Threaded _____

Blank casing diameter 14 in. to _____ ft. Dia _____ in. to _____ ft. Dia _____ in. to _____ ft.

Casing height above land surface _____ in., weight _____ lbs./ft. Wall thickness or gauge No. _____

TYPE OF SCREEN OR PERFORATION MATERIAL:

1 Steel

3 Stainless steel

5 Fiberglass

7 PVC

10 Asbestos-cement

2 Brass

4 Galvanized steel

6 Concrete tile

8 RMP (SR)

11 Other (specify)

SCREEN OR PERFORATION OPENINGS ARE:

1 Continuous slot

3 Mill slot

5 Gauzed wrapped

8 Saw cut

11 None (open hole)

2 Louvered shutter

4 Key punched

6 Wire wrapped

9 Drilled holes

7 Torch cut

10 Other (specify)

SCREEN-PERFORATED INTERVALS:

From _____ ft. to _____ ft. From _____ ft. to _____ ft.

From _____ ft. to _____ ft. From _____ ft. to _____ ft.

GRAVEL PACK INTERVALS:

From _____ ft. to _____ ft. From _____ ft. to _____ ft.

From _____ ft. to _____ ft. From _____ ft. to _____ ft.

6 GROUT MATERIAL:

1 Neat cement

2 Cement grout

3 Bentonite

4 Other

Grout Intervals From _____ ft. to _____ ft. From _____ ft. to _____ ft. From _____ ft. to _____ ft.

What is the nearest source of possible contamination:

1 Septic tank

4 Lateral lines

7 Pit privy

10 Livestock pens

14 Abandoned water well

2 Sewer lines

5 Cess pool

8 Sewage lagoon

11 Fuel storage

15 Oil well/ Gas well

3 Watertight sewer lines

6 Seepage pit

9 Feedyard

12 Fertilizer storage

16 Other (specify below)

13 Insecticide storage

None observed

Direction from well?

How many feet?

FROM TO CODE LITHOLOGIC LOG FROM TO PLUGGING INTERVALS

430 185 Gravel Fill
185 175 Bentonite Plug
175 17 Fill
17 5 Cement Plug

7 CONTRACTOR'S OR LANDOWNER'S CERTIFICATION: This water well was (1) constructed, (2) reconstructed, or (3) plugged under my jurisdiction and was

completed on (mo/day/yr) 9-27-06

and this record is true to the best of my knowledge and belief. Kansas

Water Well Contractor's License No. 473

This Water Well Record was completed on (mo/day/yr) 9-28-06

under the business name of Tyler Water Well Serv

by (signature) Paul J. J.

INSTRUCTIONS: Please fill in blanks and circle the correct answers. Send three copies to Kansas Department of Health and Environment, Bureau of Water, Topeka, Kansas 66620-0001 Telephone: 913-296-5545. Send one to WATER WELL OWNER and retain one for your records.