

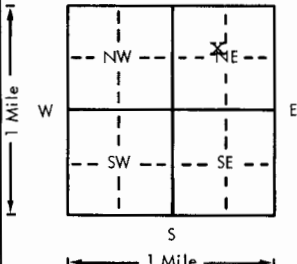
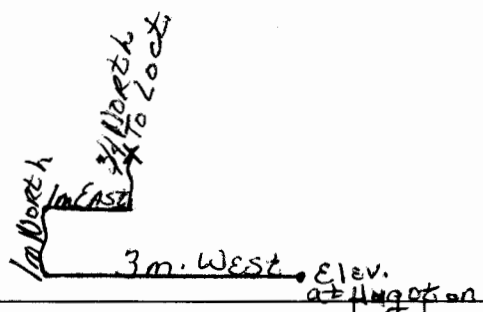
USE TYPEWRITER OR BALL  
POINT PEN-PRESS FIRMLY,  
PRINT CLEARLY.

WATER WELL RECORD  
KSA 82a-1201-1215

Kansas Department of Health and  
Environment-Division of Environment  
(Water well Contractors)  
Topeka, Kansas 66620

CWW Inv.#14498

Bane H-1

1. Location of well:	County <b>Stevens</b>	Fraction <b>SE 1/4 NW 1/4 NE 1/4</b>	Section number <b>1</b>	Township number <b>T 33S</b>	Range number <b>S R 38E</b>
2. Distance and direction from nearest town or city: <b>From Hugoton Elev. go 3m West - 1m North - 1m East - 3/4m North</b>			3. Owner of well: <b>Anadarko Production Company</b>		
Street address of well location if in city: <b>West into location.</b>			City, state, zip code: <b>Liberal, Kansas 67901</b>		
4. Locate with "X" in section below: N  W S E 1 Mile			Sketch map: 		
5. Type and color of material			From	To	6. Bore hole dia. <u>9</u> in. Completion date <u>3-30</u> Well depth <u>240</u> ft.
Surface			0	2	7. <input type="checkbox"/> Cable tool <input checked="" type="checkbox"/> Rotary <input type="checkbox"/> Driven <input type="checkbox"/> Dug <input type="checkbox"/> Hollow rod <input type="checkbox"/> Jetted <input type="checkbox"/> Bored <input type="checkbox"/> Reverse rotary
Sandy clay			2	40	8. Use: <input type="checkbox"/> Domestic <input type="checkbox"/> Public supply <input checked="" type="checkbox"/> Industry <input type="checkbox"/> Irrigation <input type="checkbox"/> Air conditioning <input type="checkbox"/> Stock <input type="checkbox"/> Lawn <input checked="" type="checkbox"/> Oil field water <input type="checkbox"/> Other
Fine sand			40	100	9. Casing: Material <input type="checkbox"/> Height: <u>Above</u> or below Threaded <input type="checkbox"/> Welded <input type="checkbox"/> Surface <u>28</u> in. RMP <input type="checkbox"/> PVC <input checked="" type="checkbox"/> Weight <u>2.78</u> lbs./ft. Dia. <u>5</u> in. to <u>170</u> ft. depth Wall Thickness: inches or Dia. <u>5</u> in. to <u>240</u> ft. depth gage No. <u>.265</u>
Sandy clay			100	130	10. Screen: Manufacturer's name <u>Sawed perf.</u> Type <u>PVC</u> Dia. <u>5"</u> Slot/gauze <u>60'</u> Length <u>60'</u> Set between <u>170</u> ft. and <u>230</u> ft. <u>ft.</u> and <u>ft.</u> Gravel pack? <u>yes</u> Size range of material <u>1/8-3/16</u>
Fine sand & medium to large sand 40-60			130	240	11. Static water level: <u>120</u> ft. below land surface Date <u>3-30-78</u> mo./day/yr.
					12. Pumping level below land surfaces: <u>ft.</u> after <u>hrs.</u> pumping <u>g.p.m.</u> <u>ft.</u> after <u>hrs.</u> pumping <u>g.p.m.</u> Estimated maximum yield <u>40</u> g.p.m.
					13. Water sample submitted: <u>mo./day/yr.</u> <u>Yes</u> <input checked="" type="checkbox"/> <u>No</u> Date
					14. Well head completion: <u>28</u> inches above grade <u>Pitless adapter</u>
					15. Well grouted? <u>yes</u> With: <input checked="" type="checkbox"/> Neat cement <input type="checkbox"/> Bentonite <input type="checkbox"/> Concrete Depth: From <u>0</u> ft. to <u>10</u> ft.
					16. Nearest source of possible contamination: ft. <u>100</u> Direction <u>NE</u> Type <u>oil well</u> Well disinfected upon completion? <input checked="" type="checkbox"/> Yes <input type="checkbox"/> No
					17. Pump: <input checked="" type="checkbox"/> Not installed Manufacturer's name Model number <u>HP</u> Volts Length of drop pipe <u>ft.</u> capacity <u>g.p.m.</u> Type: <input type="checkbox"/> Submersible <input type="checkbox"/> Turbine <input type="checkbox"/> Jet <input type="checkbox"/> Reciprocating <input type="checkbox"/> Centrifugal <input type="checkbox"/> Other
(Use a second sheet if needed)					
18. Elevation:	19. Remarks:		20. Water well contractor's certification: This well was drilled under my jurisdiction and this report is true to the best of my knowledge and belief. <b>Carlile Water Well Ser. 118</b> Business name <u>Carlile Water Well Ser. 118</u> License No. <u>118</u> Address <u>Box 275, Liberal, KS</u> Signed <u>Edward E. Mann</u> Date <u>3-31</u> Authorized representative		
Topography: <input type="checkbox"/> Hill <input type="checkbox"/> Slope <input checked="" type="checkbox"/> Upland <input type="checkbox"/> Valley					

33 38E 1 SE 1/4 1/4 1/4