

PERMIT #T-78-70

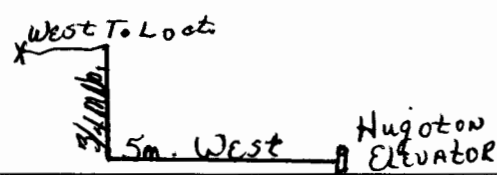
USE TYPEWRITER OR BALL  
POINT PEN-PRESS FIRMLY,  
PRINT CLEARLY.

WATER WELL RECORD  
KSA 82a-1201-1215

Kansas Department of Health and  
Environment-Division of Environment  
(Water well Contractors)  
Topeka, Kansas 66620

CWW Inv. #14540

Troup B-2

1. Location of well:		County <b>Stevens</b>	Fraction <b>SW 1/4 NE 1/4 NE 1/4</b>	Section number <b>9</b>	Township number <b>T 33S</b>	Range number <b>S R 38W E/W</b>
2. Distance and direction from nearest town or city: <b>Go 5M West - 3/4 M North - West to location.</b>			3. Owner of well: <b>Anadarko Production Company</b> R.R. or street: <b>c/o P. Gatlin, Box 351</b> City, state, zip code: <b>Liberal, Kansas 67901</b>			
4. Locate with "X" in section below: N W E S 1 Mile 1 Mile		Sketch map: 		6. Bore hole dia. <u>9</u> in. Completion date <u>4-14</u> Well depth <u>300</u> ft.		
5. Type and color of material		From		To		7. <input type="checkbox"/> Cable tool <input checked="" type="checkbox"/> Rotary <input type="checkbox"/> Driven <input type="checkbox"/> Dug <input type="checkbox"/> Hollow rod <input type="checkbox"/> Jetted <input type="checkbox"/> Bored <input type="checkbox"/> Reverse rotary
						8. Use: <input type="checkbox"/> Domestic <input type="checkbox"/> Public supply <input checked="" type="checkbox"/> Industry <input type="checkbox"/> Irrigation <input type="checkbox"/> Air conditioning <input type="checkbox"/> Stock <input type="checkbox"/> Lawn <input checked="" type="checkbox"/> Oil field water <input type="checkbox"/> Other
						9. Casing: Material <input type="checkbox"/> Height: <u>Above</u> or below Threaded <input type="checkbox"/> Welded <input type="checkbox"/> Surface <u>28</u> in. RMP <input type="checkbox"/> PVC <input checked="" type="checkbox"/> Weight <u>2.78</u> lbs./ft. Dia. <u>5</u> in. to <u>195</u> ft. depth Wall Thickness: inches or Dia. <u>5</u> in. to <u>300</u> ft. depth gage No. <u>265</u>
						10. Screen: Manufacturer's name <u>Sawed perf.</u> Type <u>PVC</u> Dia. <u>5"</u> Slot/gauze <u>100'</u> Length <u>100'</u> Set between <u>195</u> ft. and <u>295</u> ft. ft. and <u>        </u> ft. Gravel pack? <u>yes</u> Size range of material <u>1/8-3/16</u>
						11. Static water level: <u>120</u> ft. below land surface Date <u>4/14/78</u> mo./day/yr.
12. Pumping level below land surfaces: <u>        </u> ft. after <u>        </u> hrs. pumping <u>        </u> g.p.m. <u>        </u> ft. after <u>        </u> hrs. pumping <u>        </u> g.p.m. Estimated maximum yield <u>40</u> g.p.m.		13. Water sample submitted: <u>        </u> mo./day/yr. <u>        </u> Yes <input checked="" type="checkbox"/> No <input type="checkbox"/> Date <u>        </u>				
		14. Well head completion: <u>        </u> Pitless adapter <u>28</u> inches above grade				
		15. Well grouted? <u>yes</u> With: <input checked="" type="checkbox"/> Neat cement <input type="checkbox"/> Bentonite <input type="checkbox"/> Concrete Depth: From <u>0</u> ft. to <u>10</u> ft.				
		16. Nearest source of possible contamination: ft. <u>100</u> Direction <u>NE</u> Type <u>oilwell</u> Well disinfected upon completion? <input checked="" type="checkbox"/> Yes <input type="checkbox"/> No				
		17. Pump: <input checked="" type="checkbox"/> Not installed Manufacturer's name <u>        </u> Model number <u>        </u> HP <u>        </u> Volts <u>        </u> Length of drop pipe <u>        </u> ft. capacity <u>        </u> g.p.m. Type: <input type="checkbox"/> Submersible <input type="checkbox"/> Turbine <input type="checkbox"/> Jet <input type="checkbox"/> Reciprocating <input type="checkbox"/> Centrifugal <input type="checkbox"/> Other				
(Use a second sheet if needed)						
18. Elevation:  Topography: <input type="checkbox"/> Hill <input type="checkbox"/> Slope <input checked="" type="checkbox"/> Upland <input type="checkbox"/> Valley		19. Remarks:		20. Water well contractor's certification: This well was drilled under my jurisdiction and this report is true to the best of my knowledge and belief. <b>Carlile Water Well Service 118</b> Business name <u>Box 275, Liberal, KS</u> License No. <u>        </u> Address <u>        </u> Signed <u>Edward E. Myers</u> Date <u>4-17-78</u> Authorized representative		

33 380 9 SW NE