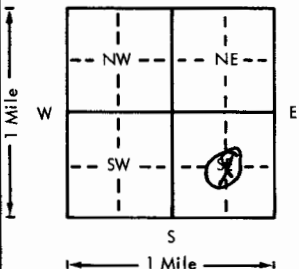
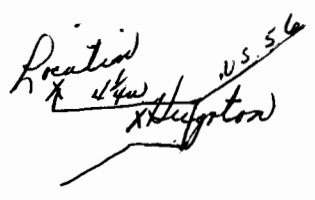


USE TYPEWRITER OR BALL
POINT PEN-PRESS FIRMLY,
PRINT CLEARLY.

WATER WELL RECORD
KSA 82a-1201-1215

Kansas Department of Health and
Environment-Division of Environment
(Water well Contractors)
Topeka, Kansas 66620

1. Location of well:	County Stevens	Fraction 1/4 1/4 C-SE 1/4	Section number 10	Township number T 33 S R 38 E/W	Range number 38
2. Distance and direction from nearest town or city: 4 1/4 west of Hugoton & north to loc. Street address of well location if in city:			3. Owner of well: Anadarko Production Co. R.R. or street: P. O. Box 349 City, state, zip code: Liberal, Kansas 67901		
4. Locate with "X" in section below: <div style="text-align: center;">N 1 Mile W  E S 1 Mile</div>			Sketch map: 		
5. Type and color of material			6. Bore hole dia. 9 in. Completion date 2-28-77 Well depth 220 ft.		
			7. <input type="checkbox"/> Cable tool <input checked="" type="checkbox"/> Rotary <input type="checkbox"/> Driven <input type="checkbox"/> Dug <input type="checkbox"/> Hollow rod <input type="checkbox"/> Jetted <input type="checkbox"/> Bored <input type="checkbox"/> Reverse rotary		
			8. Use: <input type="checkbox"/> Domestic <input type="checkbox"/> Public supply <input type="checkbox"/> Industry <input type="checkbox"/> Irrigation <input type="checkbox"/> Air conditioning <input type="checkbox"/> Stock <input type="checkbox"/> Lawn <input checked="" type="checkbox"/> Oil field water <input type="checkbox"/> Other		
			9. Casing: Material <input type="checkbox"/> Height: Above or below Threaded <input type="checkbox"/> Welded <input type="checkbox"/> Surface 28 in. RMP <input type="checkbox"/> PVC <input checked="" type="checkbox"/> Weight 2.78 lbs./ft. Dia. 5 in. to 120 ft. depth Wall Thickness: inches or Dia. 5 in. to 220 ft. depth gage No. .265		
			10. Screen: Manufacturer's name sawed perf. Type PVC Dia. 5" Slot/gauze 90 Length 210 ft. Set between 120 ft. and 210 ft. Gravel pack? yes Size range of material 1/8 to 3/16		
			11. Static water level: 100 ft. below land surface Date 2-28-77 mo./day/yr.		
			12. Pumping level below land surfaces: ____ ft. after ____ hrs. pumping ____ g.p.m. ____ ft. after ____ hrs. pumping ____ g.p.m. Estimated maximum yield 50 g.p.m.		
			13. Water sample submitted: ____ mo./day/yr. Yes <input checked="" type="checkbox"/> No <input type="checkbox"/> Date ____		
			14. Well head completion: 28 inches above grade <input type="checkbox"/> Pitless adapter		
			15. Well grouted? yes With: <input checked="" type="checkbox"/> Neat cement <input type="checkbox"/> Bentonite <input type="checkbox"/> Concrete Depth: From 0 ft. to 10 ft.		
			16. Nearest source of possible contamination: oil well ft. 100 Direction NE Type oil well Well disinfected upon completion? <input checked="" type="checkbox"/> Yes <input type="checkbox"/> No		
			17. Pump: <input checked="" type="checkbox"/> Not installed Manufacturer's name ____ Model number ____ HP ____ Volts ____ Length of drop pipe ____ ft. capacity ____ g.p.m. Type: <input type="checkbox"/> Submersible <input type="checkbox"/> Turbine <input type="checkbox"/> Jet <input type="checkbox"/> Reciprocating <input type="checkbox"/> Centrifugal <input type="checkbox"/> Other		
			(Use a second sheet if needed)		
18. Elevation:		19. Remarks:			
Topography: <input type="checkbox"/> Hill <input type="checkbox"/> Slope <input checked="" type="checkbox"/> Upland <input type="checkbox"/> Valley		20. Water well contractor's certification: This well was drilled under my jurisdiction and this report is true to the best of my knowledge and belief. Carlile Water Well 118 Business name Box 275, Liberal, Ks. License No. ____ Address ____ Signed Edward E. Means Date 3-9-77 Authorized representative			