


1 LOCATION OF WATER WELL:	Fraction	Section Number	Township Number	Range Number
County: STEVENS	SE 1/4 SE 1/4 NE 1/4	12	T 33 S	R 38 EW

Distance and direction from nearest town or city street address of well if located within city?

FROM HUGOTON JCT. 25&26 NORTH ACROSS RR TRACKS & WEST 3 MILES, 1/2 SOUTH & WEST INTO LOC.

2 WATER WELL OWNER: MC COY PETROLEUM	#1-12 ELLIS "B"
RR#, St. Address, Box #: 110 SOUTH MAIN, SUITE #500	Board of Agriculture, Division of Water Resources
City, State, ZIP Code: WICHITA, KS 67202	Application Number: 940361

3 LOCATE WELL'S LOCATION WITH AN "X" IN SECTION BOX:	4 DEPTH OF COMPLETED WELL: 3420 ft. ELEVATION:
--	--

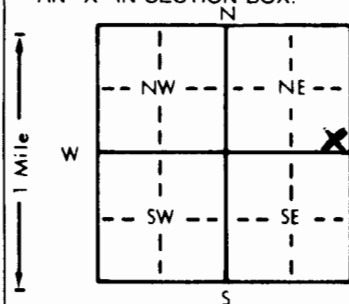

Depth(s) Groundwater Encountered 1. 160 ft. 2. 170 ft. 3. 9-6-94	WELL'S STATIC WATER LEVEL 160 ft. below land surface measured on mo/day/yr
Pump test data: Well water was 170 ft. after 1 hours pumping 125 gpm	Est. Yield 125 gpm: Well water was 170 ft. after 1 hours pumping 125 gpm
Bore Hole Diameter 11 in. to 340 ft. and in. to ft.	WELL WATER TO BE USED AS:
1 Domestic 3 Feedlot 6 Oil field water supply 9 Dewatering 12 Other (Specify below)	2 Irrigation 4 Industrial 7 Lawn and garden only 10 Monitoring well
Was a chemical/bacteriological sample submitted to Department? Yes No X	If yes, mo/day/yr sample was submitted
Water Well Disinfected? Yes X No	

5 TYPE OF BLANK CASING USED:	5 Wrought iron 8 Concrete tile CASING JOINTS: Glued X Clamped
1 Steel 3 RMP (SR) 6 Asbestos-Cement 9 Other (specify below) Welded	2 PVC 4 ABS 7 Fiberglass Threaded

Blank casing diameter 6 in. to 340 ft. Dia. in. to ft. Dia. in. to ft.	Casing height above land surface 24 in. weight 2.902 lbs./ft. Wall thickness or gauge No. .316 SDR 21
--	---

TYPE OF SCREEN OR PERFORATION MATERIAL:	7 PVC 10 Asbestos-cement
1 Steel 3 Stainless steel 5 Fiberglass 8 RMP (SR) 11 Other (specify)	2 Brass 4 Galvanized steel 6 Concrete tile 9 ABS 12 None used (open hole)

SCREEN OR PERFORATION OPENINGS ARE:	5 Gauzed wrapped 8 Saw cut 11 None (open hole)
1 Continuous slot 3 Mill slot 6 Wire wrapped 9 Drilled holes	2 Louvered shutter 4 Key punched 7 Torch cut 10 Other (specify)

SCREEN-PERFORATED INTERVALS:	From 260 ft. to 300 ft. From 320 ft. to 340 ft. From 220 ft. to 340 ft.
GRAVEL PACK INTERVALS:	From 220 ft. to 340 ft. From 220 ft. to 340 ft. From 220 ft. to 340 ft.

6 GROUT MATERIAL:	1 Neat cement 2 Cement grout 3 Bentonite 4 Other HOLE PLUG
Grout Intervals: From 1 ft. to 20 ft. From 1 ft. to 20 ft. From 1 ft. to 20 ft.	

What is the nearest source of possible contamination:	10 Livestock pens 14 Abandoned water well
1 Septic tank 4 Lateral lines 7 Pit privy 11 Fuel storage 15 Oil well/Gas well	2 Sewer lines 5 Cess pool 8 Sewage lagoon 12 Fertilizer storage 16 Other (specify below)
3 Watertight sewer lines 6 Seepage pit 9 Feedyard 13 Insecticide storage	

Direction from well? Southeast	How many feet? 200
--------------------------------	--------------------

FROM	TO	LITHOLOGIC LOG	FROM	TO	PLUGGING INTERVALS
0	3	TOP			
3	42	SANDY CLAY			
42	63	SAND W/CLAY STREAKS			
63	84	CLAY			
84	114	SANDY CLAY			
114	297	SAND & GRAVEL			
297	324	BLUE & YELLOW CLAY			
324	340	BLACK CLAY			

7 CONTRACTOR'S OR LANDOWNER'S CERTIFICATION: This water well was (1) constructed, (2) reconstructed, or (3) plugged under my jurisdiction and was completed on (mo/day/year) 9-6-94 and this record is true to the best of my knowledge and belief. Kansas Water Well Contractor's License No. KWWCL-430 This Water Well Record was completed on (mo/day/yr) 9-6-94 under the business name of HOWARD DRUG CO. BOX 806 BEAVER, OK 73932 by signature
--