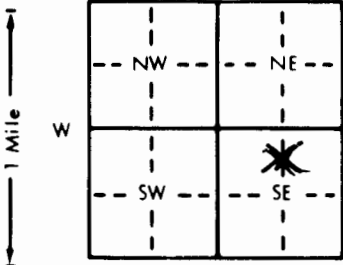


1 LOCATION OF WATER WELL: County: STEVENS		Fraction NC 1/4 SE 1/4	Section Number 1	Township Number T 33 S	Range Number R 38W EW	
Distance and direction from nearest town or city street address to well if located within city? 2 MILES NORTHWEST OF HUGOTON, KS	
2 WATER WELL OWNER: ANADARKO PET RR#, St. Address, Box #: BOX 351 City, State, ZIP Code: LIBERAL, KS 67905			#2 LOFLIN "A" Board of Agriculture, Division of Water Resources Application Number: 940360	
3 LOCATE WELL'S LOCATION WITH AN "X" IN SECTION BOX: 		4 DEPTH OF COMPLETED WELL: 400 ft. ELEVATION: Depth(s) Groundwater Encountered 1. 245 ft. 2. ft. 3. ft. WELL'S STATIC WATER LEVEL: 245 ft. below land surface measured on mo/day/yr 8-30-94 Pump test data: Well water was 260 ft. after 1 hours pumping gpm Est. Yield gpm: Well water was ft. after hours pumping gpm Bore Hole Diameter: 11 in. to 400 ft. and in. to ft. WELL WATER TO BE USED AS: 5 Public water supply 8 Air conditioning 11 Injection well 1 Domestic 3 Feedlot 6 Oil field water supply 9 Dewatering 12 Other (Specify below) 2 Irrigation 4 Industrial 7 Lawn and garden only 10 Monitoring well Was a chemical/bacteriological sample submitted to Department? Yes No X; If yes, mo/day/yr sample was submitted Water Well Disinfected? Yes X No	
5 TYPE OF BLANK CASING USED: 1 Steel 3 RMP (SR) 5 Wrought iron 8 Concrete tile CASING JOINTS: Glued X Clamped 2 PVC 4 ABS 6 Asbestos-Cement 9 Other (specify below) Welded Blank casing diameter: 6 in. to 400 ft. Dia in. to ft. Dia in. to ft. Casing height above land surface: 24 in., weight 2.902 lbs./ft. Wall thickness or gauge No. 316 SDR 21 TYPE OF SCREEN OR PERFORATION MATERIAL: 1 Steel 3 Stainless steel 5 Fiberglass 8 RMP (SR) 10 Asbestos-cement 2 Brass 4 Galvanized steel 6 Concrete tile 9 ABS 11 Other (specify) SCREEN OR PERFORATION OPENINGS ARE: 1 Continuous slot 3 Mill slot 5 Gauzed wrapped 8 Saw cut 11 None (open hole) 2 Louvered shutter 4 Key punched 6 Wire wrapped 9 Drilled holes 7 Torch cut 10 Other (specify) SCREEN-PERFORATED INTERVALS: From 300 ft. to 400 ft. From ft. to ft. GRAVEL PACK INTERVALS: From 340 ft. to 400 ft. From ft. to ft. From ft. to ft. From ft. to ft.	
6 GROUT MATERIAL: 1 Heat cement 2 Cement grout 3 Bentonite 4 Other HOLE PLUG Grout Intervals: From 1 ft. to 20 ft. From ft. to ft. From ft. to ft. What is the nearest source of possible contamination: 1 Septic tank 4 Lateral lines 7 Pit privy 10 Livestock pens 14 Abandoned water well 2 Sewer lines 5 Cess pool 8 Sewage lagoon 11 Fuel storage 15 Oil well/Gas well 3 Watertight sewer lines 6 Seepage pit 9 Feedyard 12 Fertilizer storage 16 Other (specify below) 13 Insecticide storage Direction from well? North How many feet? 250	
<table border="1"><thead><tr><th>FROM</th><th>TO</th><th>LITHOLOGIC LOG</th><th>FROM</th><th>TO</th><th>PLUGGING INTERVALS</th></tr></thead><tbody><tr><td>0</td><td>2</td><td>SANDY CLAY</td><td>257</td><td>269</td><td>COARSE SAND</td></tr><tr><td>2</td><td>7</td><td>SANDY CLAY</td><td>269</td><td>281</td><td>SANDY CLAY</td></tr><tr><td>7</td><td>31</td><td>SANDY CLAY</td><td>281</td><td>294</td><td>SMALL GRAVEL & SAND</td></tr><tr><td>31</td><td>55</td><td>SANDY CLAY</td><td>294</td><td>302</td><td>SANDY CLAY</td></tr><tr><td>55</td><td>65</td><td>SAND</td><td>302</td><td>316</td><td>MED. GRAVEL & SAND</td></tr><tr><td>65</td><td>82</td><td>SANDY CLAY</td><td>316</td><td>321</td><td>SANDY CLAY</td></tr><tr><td>82</td><td>102</td><td>COARSE SAND</td><td>321</td><td>361</td><td>MED. GRAVEL & COARSE SAND</td></tr><tr><td>102</td><td>115</td><td>GRAVEL MED. SAND</td><td>361</td><td>375</td><td>GOLD SAND</td></tr><tr><td>115</td><td>137</td><td>SAND</td><td>375</td><td>389</td><td>MED. GRAVEL</td></tr><tr><td>137</td><td>142</td><td>SMALL GRAVEL</td><td>389</td><td>400</td><td>YELLOW SANDY CLAY</td></tr><tr><td>142</td><td>169</td><td>COARSE SAND</td><td></td><td></td><td></td></tr><tr><td>169</td><td>181</td><td>FINE SAND</td><td></td><td></td><td></td></tr><tr><td>181</td><td>221</td><td>COARSE SAND</td><td></td><td></td><td></td></tr><tr><td>221</td><td>246</td><td>MED. GRAVEL & SAND</td><td></td><td></td><td></td></tr><tr><td>246</td><td>257</td><td>GOLD COARSE SAND</td><td></td><td></td><td></td></tr>
7 CONTRACTOR'S OR LANDOWNER'S CERTIFICATION: This water well was (1) constructed, (2) reconstructed, or (3) plugged under my jurisdiction and was completed on (mo/day/year) 8-30-94 and this record is true to the best of my knowledge and belief. Kansas Water Well Contractor's License No. KWWCL-430 This Water Well Record was completed on (mo/day/yr) 8-30-94 under the business name of HOWARD DRUG CO. BOX 806 BEAVER, OK 73932 by (signature)	