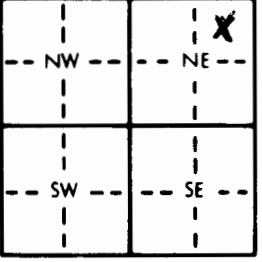
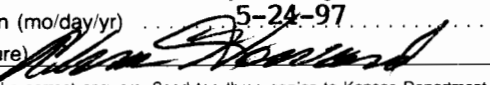


1 LOCATION OF WATER WELL:		Fraction	Section Number	Township Number	Range Number
County: Stevens		C $\frac{1}{4}$ NE $\frac{1}{4}$ NE $\frac{1}{4}$	24	T 33 S	R 39 EW
Distance and direction from nearest town or city street address of well if located within city? From Peterita; 1N., 1W., 1/4S., W into					
2 WATER WELL OWNER: Anadarko Pet.		Gregory D-2 Board of Agriculture, Division of Water Resources Application Number: 970240			
RR#, St. Address, Box #: P.O. box 351					
City, State, ZIP Code: Liberal, Ks 67905					
3 LOCATE WELL'S LOCATION WITH AN "X" IN SECTION BOX:		4 DEPTH OF COMPLETED WELL: 340 ft. ELEVATION: ft.			
		Depth(s) Groundwater Encountered 1. 131 ft. 2. ft. 3. ft.			
		WELL'S STATIC WATER LEVEL 131 ft. below land surface measured on mo/day/yr 5-24-97			
		Pump test data: Well water was 258 ft. after 1 hours pumping 100 gpm			
		Est. Yield 100 gpm: Well water was ft. after hours pumping gpm			
		Bore Hole Diameter 11 in. to 340 ft., and in. to ft.			
		WELL WATER TO BE USED AS: 5 Public water supply 8 Air conditioning 11 Injection well			
		1 Domestic 3 Feedlot 6 Oil field water supply 9 Dewatering 12 Other (Specify below)			
		2 Irrigation 4 Industrial 7 Lawn and garden only 10 Monitoring well			
		Was a chemical/bacteriological sample submitted to Department? Yes No X If yes, mo/day/yr sample was submitted			
		Water Well Disinfected? Yes X No			
5 TYPE OF BLANK CASING USED:		CASING JOINTS: Glued X Clamped			
1 Steel 3 RMP (SR) 5 Wrought iron 8 Concrete tile		Welded			
2 PVC 4 ABS 6 Asbestos-Cement 9 Other (specify below)		Threaded			
Blank casing diameter 6 in. to 340 ft., Dia in. to ft., Dia in. to ft.					
Casing height above land surface 24 in., weight 2.902 lbs./ft. Wall thickness or gauge No. 281 SDR 21					
TYPE OF SCREEN OR PERFORATION MATERIAL:		7 PVC 10 Asbestos-cement			
1 Steel 3 Stainless steel 5 Fiberglass 8 RMP (SR) 11 Other (specify)					
2 Brass 4 Galvanized steel 6 Concrete tile 9 ABS 12 None used (open hole)					
SCREEN OR PERFORATION OPENINGS ARE:		5 Gauzed wrapped 8 Saw cut 11 None (open hole)			
1 Continuous slot 3 Mill slot 6 Wire wrapped 9 Drilled holes					
2 Louvered shutter 4 Key punched 7 Torch cut 10 Other (specify)					
SCREEN-PERFORATED INTERVALS: From 240 ft. to 340 ft., From ft. to ft.					
GRAVEL PACK INTERVALS: From 140 ft. to 340 ft., From ft. to ft.					
6 GROUT MATERIAL: 1 Neat cement 2 Cement grout 3 Bentonite 4 Other Hole Plug					
Grout Intervals: From 0 ft. to 20 ft., From ft. to ft.					
What is the nearest source of possible contamination:		10 Livestock pens 14 Abandoned water well			
1 Septic tank 4 Lateral lines 7 Pit privy 11 Fuel storage 15 Oil well/Gas well					
2 Sewer lines 5 Cess pool 8 Sewage lagoon 12 Fertilizer storage 16 Other (specify below)					
3 Watertight sewer lines 6 Seepage pit 9 Feedyard 13 Insecticide storage					
Direction from well? West		How many feet? 150			
FROM TO LITHOLOGIC LOG FROM TO PLUGGING INTERVALS					
0 24 Sandy Clay / Clay					
24 65 Sand / Clay Streaks					
65 89 Sandy Clay / Clay					
89 115 Sand / Clay Streaks					
115 189 Sandy Clay / Clay					
189 257 Clay / Fine Sand STreaks					
257 267 Sand					
267 282 Clay / Sand Streaks					
282 307 Coarse Sand					
307 315 Coarse Sand / Clay STreaks					
315 340 Red/Yellow Clay					
7 CONTRACTOR'S OR LANDOWNER'S CERTIFICATION: This water well was (1) constructed, (2) reconstructed, or (3) plugged under my jurisdiction and was completed on (mo/day/year) 5-24-97 and this record is true to the best of my knowledge and belief. Kansas Water Well Contractor's License No. KWCL - 430 This Water Well Record was completed on (mo/day/yr) 5-24-97 under the business name of Howard Drlg. Box 806 Beaver, Ok 73932 by (signature) 					
INSTRUCTIONS: Use typewriter or ball point pen. PLEASE PRESS FIRMLY and PRINT clearly. Please fill in blanks, underline or circle the correct answers. Send top three copies to Kansas Department of Health and Environment, Bureau of Water, Topeka, Kansas 66620-0001. Telephone: 913-296-5545. Send one to WATER WELL OWNER and retain one for your records.					