

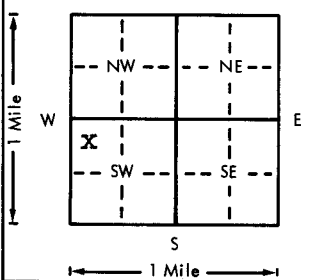
USE TYPEWRITER OR BALL
POINT PEN-PRESS FIRMLY,
PRINT CLEARLY.

WATER WELL RECORD
KSA 82a-1201-1215

Kansas Department of Health and
Environment-Division of Environment
(Water well Contractors)
Topeka, Kansas 66620

CWW Inv. #13678

Low #1

1. Location of well:		County Morton	Fraction 1/4 NW 1/4 SW 1/4	Section number 4	Township number T 33S	Range number S R 40W	E/W
2. Distance and direction from nearest town or city:		From Rolla go North across river brdg. to 1st section line run- ning west, go South thru pasture 3 mi.					
Street address of well location if in city:		Owner of well: Rains & Williamson Oil Corp. R.R. or street: 435 Page Court, 220 W. Douglas City, state, zip code: Wichita, Kansas 67002					
4. Locate with "X" in section below:		Sketch map:		6. Bore hole dia. 9 in. Completion date 7/28/77 Well depth 220 ft.			
		until rd divides (2gas wells) left go 1/4 mi. ,loct. on left side of road.		7. <input checked="" type="checkbox"/> Cable tool <input checked="" type="checkbox"/> Rotary <input type="checkbox"/> Driven <input type="checkbox"/> Dug <input type="checkbox"/> Hollow rod <input type="checkbox"/> Jetted <input type="checkbox"/> Bored <input type="checkbox"/> Reverse rotary			
5. Type and color of material		From		To		8. Use: <input type="checkbox"/> Domestic <input type="checkbox"/> Public supply <input checked="" type="checkbox"/> Industry <input type="checkbox"/> Irrigation <input type="checkbox"/> Air conditioning <input type="checkbox"/> Stock <input type="checkbox"/> Lawn <input checked="" type="checkbox"/> Oil field water <input type="checkbox"/> Other	
Surface		0		2		9. Casing: Material <input type="checkbox"/> Height: Above or below Threaded <input type="checkbox"/> Welded <input type="checkbox"/> Surface 28 in. RMP <input type="checkbox"/> PVC <input checked="" type="checkbox"/> Weight 2.78 lbs./ft. Dia. 5 in. to 155 ft. depth Wall Thickness: inches or Dia. 5 in. to 220 ft. depth gage No. 265	
Sandy clay		2		100		10. Screen: Manufacturer's name Sawed perf. Type PVC Dia. 5" Slot/gauze .030 Length 60' Set between 155 ft. and 215 ft. Gravel pack? yes Size range of material 1/8-3/16	
Clay & fine sand 40%		100		140		11. Static water level: 80 ft. below land surface Date 7/28/77	
Fine sand & medium to large sand		140		200		12. Pumping level below land surfaces: ____ ft. after ____ hrs. pumping ____ g.p.m. ____ ft. after ____ hrs. pumping ____ g.p.m. Estimated maximum yield 60 g.p.m.	
Clay, 60% and fine sand		200		220		13. Water sample submitted: ____ mo./day/yr. Yes <input checked="" type="checkbox"/> No <input type="checkbox"/> Date ____	
						14. Well head completion: ____ Pitless adapter 28 Inches above grade	
						15. Well grouted? yes With: <input checked="" type="checkbox"/> Neat cement <input type="checkbox"/> Bentonite <input type="checkbox"/> Concrete Depth: From 0 ft. to 10 ft.	
						16. Nearest source of possible contamination: ft. 100 Direction NE Type oilwell Well disinfected upon completion? <input checked="" type="checkbox"/> Yes <input type="checkbox"/> No	
						17. Pump: <input checked="" type="checkbox"/> Not installed Manufacturer's name ____ Model number ____ HP ____ Volts ____ Length of drop pipe ____ ft. capacity ____ g.p.m. Type: ____ Submersible ____ Turbine ____ Jet ____ Reciprocating ____ Centrifugal ____ Other	
18. Elevation:		19. Remarks:		20. Water well contractor's certification: This well was drilled under my jurisdiction and this report is true to the best of my knowledge and belief. Carlile Water Well Ser. 118 Business name Box 275, Liberal, KS License No. ____ Address Edward E. Means Date 8/16/77 Signed Edward E. Means Authorized representative			

RECEIVED

OCT 18 1979

DIVISION OF ENVIRONMENT
OF KANSAS