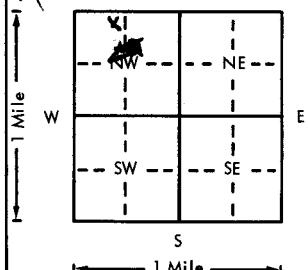


USE TYPEWRITER OR BALL  
POINT PEN-PRESS FIRMLY,  
PRINT CLEARLY.

WATER WELL RECORD  
KSA 82a-1201-1215

Kansas Department of Health and  
Environment-Division of Environment  
(Water well Contractors)  
Topeka, Kansas 66620

* Location of well:		County <u>Morton</u>	Fraction <u>NE 1/4 NW 1/4 NW 1/4</u>	Section number <u>4</u>	Township number <u>T 33 S R 40 E/W</u>	Range number
* Distance and direction from nearest town or city: <u>NE of Elkhart in 10000 acre pasture</u> Street address of well location if in city:				3. Owner of well: <u>Morton Co. Grazing Association</u> R.R. or street: <u>555 Morton</u> City, state, zip code: <u>Elkhart, KS 67950</u>		
* Locate with "X" in section below:		Sketch map:		6. Bore hole dia. <u>9</u> in. Completion date <u>9/26/77</u> Well depth <u>260</u> ft.		
				7. Cable tool <input checked="" type="checkbox"/> Rotary <input type="checkbox"/> Driven <input type="checkbox"/> Dug <input type="checkbox"/> Hollow rod <input type="checkbox"/> Jetted <input type="checkbox"/> Bored <input type="checkbox"/> Reverse rotary		
5. Type and color of material				8. Use: <input checked="" type="checkbox"/> Domestic <input type="checkbox"/> Public supply <input type="checkbox"/> Industry <input type="checkbox"/> Irrigation <input type="checkbox"/> Air conditioning <input checked="" type="checkbox"/> Stock <input type="checkbox"/> Lawn <input type="checkbox"/> Oil field water <input type="checkbox"/> Other		
				9. Casing: Material <u>PVC</u> Height: <u>Above</u> or below Threaded <input type="checkbox"/> Welded <input checked="" type="checkbox"/> Surface <u>14</u> in. RMP <input type="checkbox"/> PVC <input checked="" type="checkbox"/> Weight <u>      </u> lbs./ft. Dia. <u>5</u> in. to <u>220</u> ft. depth Wall Thickness: inches or Dia. <u>      </u> in. to <u>      </u> ft. depth gage No. <u>0-258</u>		
				10. Screen: Manufacturer's name <u>J+L</u> Type <u>PVC</u> Dia. <u>5"</u> Slot/gauze <u>1/16</u> Length <u>40'</u> Set between <u>220</u> ft. and <u>260</u> ft. <u>      </u> ft. and <u>      </u> ft. Gravel pack? <input checked="" type="checkbox"/> Yes Size range of material <u>1/8</u>		
				11. Static water level: <u>207</u> ft. below land surface Date <u>9/28/77</u> mo./day/yr.		
				12. Pumping level below land surfaces: <u>      </u> ft. after <u>      </u> hrs. pumping <u>      </u> g.p.m. <u>      </u> ft. after <u>      </u> hrs. pumping <u>      </u> g.p.m. Estimated maximum yield <u>30</u> g.p.m.		
				13. Water sample submitted: <u>      </u> mo./day/yr. <input type="checkbox"/> Yes <input checked="" type="checkbox"/> No Date <u>      </u>		
				14. Well head completion: <input type="checkbox"/> Pitless adapter <u>14</u> inches above grade		
				15. Well grouted? <input checked="" type="checkbox"/> Yes With: <input checked="" type="checkbox"/> Neat cement <input type="checkbox"/> Bentonite <input type="checkbox"/> Concrete Depth: From <u>3</u> ft. to <u>12</u> ft.		
				16. Nearest source of possible contamination: ft. <u>      </u> Direction <u>      </u> Type <u>      </u> Well disinfected upon completion? <input type="checkbox"/> Yes <input type="checkbox"/> No		
				17. Pump: <input checked="" type="checkbox"/> Not installed Manufacturer's name <u>      </u> Model number <u>      </u> HP <u>      </u> Volts <u>      </u> Length of drop pipe <u>      </u> ft. capacity <u>      </u> g.p.m. Type: <input type="checkbox"/> Submersible <input type="checkbox"/> Turbine <input type="checkbox"/> Jet <input type="checkbox"/> Reciprocating <input type="checkbox"/> Centrifugal <input type="checkbox"/> Other		
(Use a second sheet if needed)						
18. Elevation:		19. Remarks:		20. Water well contractor's certification:		
Topography: <input type="checkbox"/> Hill <input type="checkbox"/> Slope <input checked="" type="checkbox"/> Upland <input type="checkbox"/> Valley		<u>#16 None. Pasteur</u> <u>Well to be completed by:</u> <u>Start Water Well</u> <u>Elkhart, KS</u>		This well was drilled under my jurisdiction and this report is true to the best of my knowledge and belief. <u>T+W Water Well</u> <u>142</u> Business name License No. Address <u>Box 816 Liberal, KS</u> Signed <u>[Signature]</u> Date <u>9/26/77</u> Authorized representative		

33 400 4 NE 1/4 NW 1/4