WATER WELL RECORD Form WWC-5 KSA 82a-1212

1 LOCATION OF WATER WELL: County: Morton | Fraction: NW C ¼ SE ¼ NE ¼ | Section Number: 4 | Township Number: T 33 S | Range Number: R 40 E (W)

Distance and direction from nearest town or city street address of well if located within city?

7 miles SE Richfield, KS--

2 WATER WELL OWNER: Gabbert-Jones
RR#, St. Address, Box # : 333 E English
City, State, ZIP Code : Wichita, KS 67202

#2 USA "L"
Board of Agriculture, Division of Water Resources
Application Number: 920082

3 LOCATE WELL'S LOCATION WITH AN "X" IN SECTION BOX:

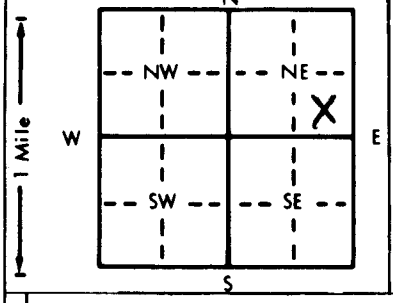

4 DEPTH OF COMPLETED WELL 280 ft. ELEVATION:

Depth(s) Groundwater Encountered 1. 25 ft. 2. ft. 3. ft.

WELL'S STATIC WATER LEVEL 25 ft. below land surface measured on mo/day/yr 03-07-92

Pump test data: Well water was 42 ft. after 1 hours pumping 120 gpm

Est. Yield 120 gpm: Well water was ft. after hours pumping gpm

Bore Hole Diameter 11 in. to 280 ft., and in. to ft.

WELL WATER TO BE USED AS: 1 Domestic 2 Irrigation 3 Feedlot 4 Industrial (6) Oil field water supply 5 Public water supply 7 Lawn and garden only 8 Air conditioning 9 Dewatering 10 Monitoring well 11 Injection well 12 Other (Specify below)

Was a chemical/bacteriological sample submitted to Department? Yes No X; If yes, mo/day/yr sample was submitted

Water Well Disinfected? Yes X No

5 TYPE OF BLANK CASING USED: (2) PVC | 1 Steel | 3 RMP (SR) | 4 ABS | 5 Wrought iron | 6 Asbestos-Cement | 7 Fiberglass | 8 Concrete tile | 9 Other (specify below)

CASING JOINTS: Glued X Clamped Welded Threaded

Blank casing diameter 6 in. to 280 ft., Dia in. to ft., Dia in. to ft.

Casing height above land surface 24 in., weight lbs./ft. Wall thickness or gauge No. .032

TYPE OF SCREEN OR PERFORATION MATERIAL: (7) PVC | 1 Steel | 2 Brass | 3 Stainless steel | 4 Galvanized steel | 5 Fiberglass | 6 Concrete tile | 8 RMP (SR) | 9 ABS | 10 Asbestos-cement | 11 Other (specify) | 12 None used (open hole)

SCREEN OR PERFORATION OPENINGS ARE: (8) Saw cut | 1 Continuous slot | 2 Louvered shutter | 3 Mill slot | 4 Key punched | 5 Gauzed wrapped | 6 Wire wrapped | 7 Torch cut | 9 Drilled holes | 10 Other (specify) | 11 None (open hole)

SCREEN-PERFORATED INTERVALS: From 200 ft. to 280 ft., From ft. to ft.

From ft. to ft., From ft. to ft.

GRAVEL PACK INTERVALS: From 100 ft. to 280 ft., From ft. to ft.

From ft. to ft., From ft. to ft.

6 GROUT MATERIAL: (1) Neat cement | 2 Cement grout | 3 Bentonite | (4) Other Hole plug

Grout Intervals: From 1 ft. to 20 ft., From ft. to ft., From ft. to ft.

What is the nearest source of possible contamination:
1 Septic tank | 2 Sewer lines | 3 Watertight sewer lines | 4 Lateral lines | 5 Cess pool | 6 Seepage pit | 7 Pit privy | 8 Sewage lagoon | 9 Feedyard | 10 Livestock pens | 11 Fuel storage | 12 Fertilizer storage | 13 Insecticide storage | 14 Abandoned water well | (15) Oil well/Gas well | 16 Other (specify below)

Direction from well? Northwest How many feet? 425

FROM	TO	LITHOLOGIC LOG	FROM	TO	PLUGGING INTERVALS
0	3	Topsoil			
3	60	Sandy Clay			
60	73	Clay			
73	92	Sandy Clay			
92	100	Clay			
100	120	Sandy Clay			
120	136	Sand			
136	140	Clay			
140	163	Sandy Clay			
163	180	Sand			
180	191	Sandy Clay			
191	211	Clay			
211	273	Sand			
273	280	Red Bed			

7 CONTRACTOR'S OR LANDOWNER'S CERTIFICATION: This water well was (1) constructed, (2) reconstructed, or (3) plugged under my jurisdiction and was completed on (mo/day/year) 03-07-92 and this record is true to the best of my knowledge and belief. Kansas Water Well Contractor's License No. KWWCL-430 This Water Well Record was completed on (mo/day/yr) 03-07-92 under the business name of Howard Drlg.Co. Box 806 Beaver,OK 73932 by (signature)

INSTRUCTIONS: Use typewriter or ball point pen. *PLEASE PRESS FIRMLY* and *PRINT* clearly. Please fill in blanks, underline or circle the correct answers. Send top three copies to Kansas Department of Health and Environment, Bureau of Water, Topeka, Kansas 66620-0001. Telephone: 913-296-5545. Send one to WATER WELL OWNER and retain one for your records.

#14102

OFFICE USE ONLY I H E/W SEC. ¼ ¼ ¼