


1 LOCATION OF WATER WELL: Fraction **C** 1/4 **SW** 1/4 **NE** 1/4 Section Number **2** Township Number **T 33 S** Range Number **R 41** **EW**  
 County: **Morton**

Distance and direction from nearest town or city street address of well if located within city? **Wilburton: 5.3N., to low water bridge .5N. 3.1E., to sign (Conestoga Trail Head) N., to 1st C.G. 100 yds. past C.G. W. to location**

2 WATER WELL OWNER: **Anadarko Petr.** #2 USA Eagley "D"  
 RR#, St. Address, Box #: **P.O. Box 351** Board of Agriculture, Division of Water Resources  
 City, State, ZIP Code: **Liberal, Ks. 67905** Application Number: **960323**

3 LOCATE WELL'S LOCATION WITH AN "X" IN SECTION BOX:

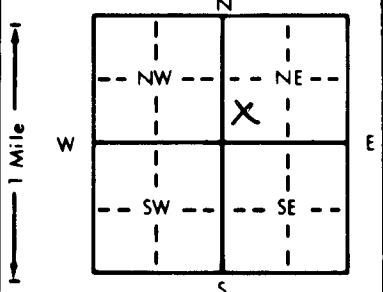

4 DEPTH OF COMPLETED WELL: **365** ft. ELEVATION:  
 Depth(s) Groundwater Encountered 1. **100** ft. 2. ft. 3. ft.  
 WELL'S STATIC WATER LEVEL **100** ft. below land surface measured on mo/day/yr **9-10-96**  
 Pump test data: Well water was **280** ft. after **1** hours pumping **120** gpm  
 Est. Yield **120** gpm: Well water was ft. after hours pumping gpm  
 Bore Hole Diameter **11** in. to **365** ft., and in. to ft.  
 WELL WATER TO BE USED AS:  
 1 Domestic 3 Feedlot **6** Oil field water supply 9 Dewatering 12 Other (Specify below)  
 2 Irrigation 4 Industrial 7 Lawn and garden only 10 Monitoring well  
 Was a chemical/bacteriological sample submitted to Department? Yes.....No...**X**..... If yes, mo/day/yr sample was submitted Water Well Disinfected? Yes **X** No

5 TYPE OF BLANK CASING USED:  
 1 Steel 3 RMP (SR) 5 Wrought iron 8 Concrete tile CASING JOINTS: Glued **X** Clamped  
**2** PVC 4 ABS 7 Fiberglass 9 Other (specify below) Welded  
 Blank casing diameter **6** in. to **0** ft., Dia **365** in. to ft., Dia in. to ft.  
 Casing height above land surface **24** in., weight **2,902** lbs./ft. Wall thickness or gauge No. **.281 SDR 21**  
 TYPE OF SCREEN OR PERFORATION MATERIAL:  
 1 Steel 3 Stainless steel 5 Fiberglass **7** PVC 10 Asbestos-cement  
 2 Brass 4 Galvanized steel 6 Concrete tile 8 RMP (SR) 11 Other (specify)  
 SCREEN OR PERFORATION OPENINGS ARE:  
 1 Continuous slot 3 Mill slot 5 Gauzed wrapped **8** Saw cut 11 None (open hole)  
 2 Louvered shutter 4 Key punched 6 Wire wrapped 9 Drilled holes  
 7 Torch cut 10 Other (specify)  
 SCREEN-PERFORATED INTERVALS: From **260** ft. to **365** ft., From ft. to ft.  
 GRAVEL PACK INTERVALS: From **160** ft. to **365** ft., From ft. to ft.

6 GROUT MATERIAL: **1** Meat cement 2 Cement grout 3 Bentonite **4** Other **Hole Plug**  
 Grout Intervals: From **0** ft. to **16** ft., From ft. to ft.  
 What is the nearest source of possible contamination:  
 1 Septic tank 4 Lateral lines 7 Pit privy 10 Livestock pens 14 Abandoned water well  
 2 Sewer lines 5 Cess pool 8 Sewage lagoon 11 Fuel storage **15** Oil well/Gas well  
 3 Watertight sewer lines 6 Seepage pit 9 Feedyard 12 Fertilizer storage 16 Other (specify below)  
 13 Insecticide storage  
 Direction from well? **Northeast** How many feet? **1500**

FROM	TO	LITHOLOGIC LOG	FROM	TO	PLUGGING INTERVALS
0	2	Surface			
2	151	Clay			
151	201	Sandy Clay / Clay			
201	218	Sandy Clay			
218	301	Sand			
301	330	Red Clay			
330	355	Sand Stone			
355	365	Red Clay			

7 CONTRACTOR'S OR LANDOWNER'S CERTIFICATION: This water well was **(1)** constructed, (2) reconstructed, or (3) plugged under my jurisdiction and was completed on (mo/day/year) **9-10-96** and this record is true to the best of my knowledge and belief. Kansas Water Well Contractor's License No. **KWCL - 430** This Water Well Record was completed on (mo/day/yr) **9-10-96** under the business name of **Howard Drlg. Box 806, Beaver, Ok 73932** by (signature) *[Signature]*