


WATER WELL RECORD Form WWC-5 KSA 82a-1212

1 LOCATION OF WATER WELL: Fraction Section Number Township Number Range Number  
 COUNTY: MORTON SE 1/4 SE 1/4 SE 1/4 33 T 33 S R 41 W

Distance and direction from nearest town or city street address of well if located within city?  
 FROM ELKHART, KS - 7 EAST ON HIGHWAY 56 AND 3 1/2 NORTH

2 WATER WELL OWNER: MORTON CO. GRAZING ASSN. *Well # 3*  
 RR#, St. Address, Box #: BOX 121 Board of Agriculture, Division of Water Resources  
 City, State, ZIP code: ELKHART, KS 67950- Application Number:

3 LOCATE WELL'S LOCATION WITH AN "X" IN SECTION BOX: 4 DEPTH OF COMPLETED WELL 190 ELEVATION: 0  
 Depth(s) Groundwater Encountered 1. 0 ft. 2. 0 ft. 3. 0 ft.

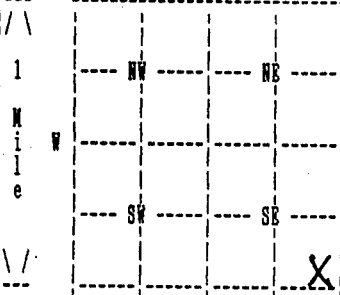

WELL'S STATIC WATER LEVEL 70 ft. below land surface measured on no/day/yr 08/27/94  
 Pump test data: Well water was 0 ft. after 0 hours pumping 0 gpm  
 Estimated Yield 25 gpm: Well water was 0 ft. after 0 hours pumping 0 gpm  
 Bore Hole Diameter 9 in. to 190 ft., and in. to 0 ft.  
 WELL WATER TO BE USED AS: DOMESTIC

Was a chemical/bacteriological sample submitted to department? No ;  
 If yes, no/day/yr sample was submitted Water well disinfected? Yes

5 TYPE OF BLANK CASING USED: PVC CASING JOINTS: GLOUED  
 Blank casing diameter 5 in. to 190 ft., Dia in. to 0 ft., Dia in. to 0 ft.  
 Casing height above land surface 12 in., weight 200 lbs/ft. Wall thickness or gauge No. 21  
 TYPE OF SCREEN OR PERFORATION MATERIAL: PVC  
 SCREEN OR PERFORATION OPENINGS ARE: SAW CUT

SCREEN PERFORATED INTERVALS: From 165 ft. to 185 ft., From 0 ft. to 0 ft.  
 From 0 ft. to 0 ft., From 0 ft. to 0 ft.  
 GRAVEL PACK INTERVALS: From 20 ft. to 190 ft., From 0 ft. to 0 ft.  
 From 0 ft. to 0 ft., From 0 ft. to 0 ft.

6 GROUT MATERIAL BENTONITE  
 Grout Intervals: From 0 ft. to 20 ft., From 0 ft. to 0 ft., From 0 ft. to 0 ft.  
 What is the nearest source of possible contamination: NONE - NEW SITE  
 Direction from well? How many feet? 0

| FROM | TO  | LITHOLOGIC LOG         | FROM | TO | PLUGGING INTERVALS |
|------|-----|------------------------|------|----|--------------------|
| 0    | 20  | TOPSOIL SANDY CLAY     |      |    |                    |
| 20   | 40  | SAND GRAVEL CLAY       |      |    |                    |
| 40   | 70  | MEDIUM SAND GRAVEL     |      |    |                    |
| 70   | 85  | MEDIUM SAND BROWN CLAY |      |    |                    |
| 85   | 105 | BROWN CLAY             |      |    |                    |
| 105  | 165 | FINE SAND              |      |    |                    |
| 165  | 190 | SAND CALACHIE CLAY     |      |    |                    |
| 190  | 200 | RED BED                |      |    |                    |

7 CONTRACTOR'S OR LANDOWNER'S CERTIFICATION: This water well was Constructed under my jurisdiction and was completed on (no/day/year) 08/27/94 and this record is true to the best of my knowledge and belief. Kansas Water Well Contractor's License No. 179 This Water Well Record was completed on (no/day/yr) 09/16/94 under the business name of JOB'S WELL SERVICE, INC. by (signature) *Judith Crick*