


WATER WELL RECORD Form WWC-5 KSA 82a-1212

1 LOCATION OF WATER WELL: Fraction Section Number Township Number Range Number
 COUNTY: MORTON SW 1/4 SW 1/4 SE 1/4 2 T 33 S R 42 W

Distance and direction from nearest town or city street address of well if located within city?
 FROM ELKHART, KS - ON HIGHWAY 27 2 1/2 MILES EAST

2 WATER WELL OWNER: JOHNSON, MARVIN JR.
 REF, St. Address, Box #: P.O. DRAWER X Board of Agriculture, Division of Water Resources
 City, State, ZIP code: ELKHART, KS 67950- Application Number:

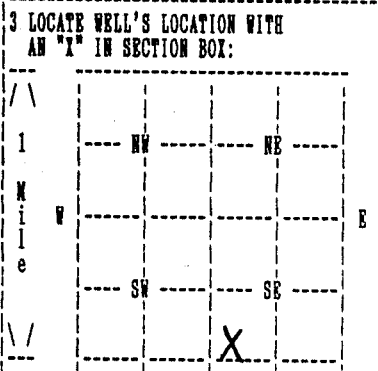

4 DEPTH OF COMPLETED WELL 138 ELEVATION: 0
 Depth(s) Groundwater Encountered 1. 0 ft. 2. 0 ft. 3. 0 ft.

WELL'S STATIC WATER LEVEL 45 ft. below land surface measured on mo/day/yr 06/14/95
 Pump testdata: Well water was 0 ft. after 0 hours pumping 0 gpm

Estimated Yield 25 gpm: Well water was 0 ft. after 0 hours pumping 0 gpm

Bore Hole Diameter 9 in. to 138 ft., and in. to 0 ft.

WELL WATER TO BE USED AS: DOMESTIC

Was a chemical/bacteriological sample submitted to department? No ;
 If yes, mo/day/yr sample was submitted Water well disinfected? Yes

5 TYPE OF BLANK CASING USED: PVC CASING JOINTS: GLUED
 Blank casing diameter 5 in. to 138 ft., Dia in. to 0 ft., Dia in. to 0 ft.
 Casing height above land surface 12 in., weight 200 lbs/ft. Wall thickness or gauge No. 21
 TYPE OF SCREEN OR PERFORATION MATERIAL: PVC
 SCREEN OR PERFORATION OPENINGS ARE: SAW CUT

SCREEN PERFORATED INTERVALS: From 103 ft. to 133 ft., From 0 ft. to 0 ft.
 From 0 ft. to 0 ft., From 0 ft. to 0 ft.

GRAVEL PACK INTERVALS: From 40 ft. to 138 ft., From 0 ft. to 0 ft.
 From 0 ft. to 0 ft., From 0 ft. to 0 ft.

6 GROUT MATERIAL BENTONITE
 Grout Intervals: From 0 ft. to 40 ft., From 0 ft. to 0 ft., From 0 ft. to 0 ft.
 What is the nearest source of possible contamination: NONE - NEW SITE
 Direction from well? How many feet? 0

FROM	TO	LITHOLOGIC LOG	FROM	TO	PLUGGING INTERVALS
0	25	PINE SAND SANDY CLAY PINE - MED SAND			
25	58	BROWN CLAY			
58	65	PINE SAND			
65	80	CLAY SANDY CLAY			
80	85	PINE SAND			
85	110	BROWN CLAY			
110	140	PINE SAND CLAY			
140	160	RED BED CLAY			

7 CONTRACTOR'S OR LANDOWNER'S CERTIFICATION: This water well was Constructed under my jurisdiction and was completed on (mo/day/year) 06/14/95 and this record is true to the best of my knowledge and belief. Kansas Water Well Contractor's License No. 179 This Water Well Record was completed on (mo/day/yr) 06/20/95 under the business name of JOE'S WELL SERVICE, INC. by (signature) *Justin Crick*