

USE TYPEWRITER OR BALL  
POINT PEN-PRESS FIRMLY,  
PRINT CLEARLY.

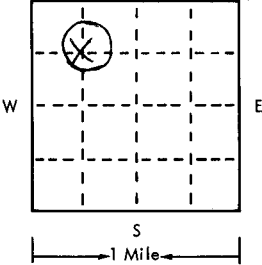
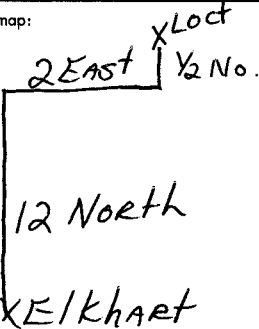
WATER WELL RECORD  
KSA 82a-1201-1215

T R EW sec 1/4 1/4 1/4 No.

Kansas State Dept. Of Health  
(Water Well Contractors)  
Forbes-Bldg. 740  
Topeka, Kansas 66620

Boehm

CWW Inv. #11222

1 Location of well:		County <b>Morton</b>	Township name	Fraction <b>NW 1/4</b>	Section number <b>10</b>	Town number <b>33S</b>	Range number <b>42W</b>
Distance and direction from nearest town or city: <b>12 Mi. North, 2 mi. East, &amp; 1/2 north of Elkhart</b>				3 Owner of well: <b>Sterling Drilling Co. % Dick Meade Box 129 Sterling, Kansas 67579</b>			
Locate with "X" in section below:		Sketch map:		4 Well depth: <b>260</b> ft. Date of completion <b>4/15/75</b> Well diameter <b>9</b> in.			
				5 <input type="checkbox"/> Cable tool <input checked="" type="checkbox"/> Rotary <input type="checkbox"/> Driven <input type="checkbox"/> Dug <input type="checkbox"/> Hollow rod <input type="checkbox"/> Jetted <input type="checkbox"/> Bored <input type="checkbox"/> Reverse rotary			
2		Type and color of material		From	To	6 Use: <input type="checkbox"/> Domestic <input type="checkbox"/> Public supply <input checked="" type="checkbox"/> Industry <input type="checkbox"/> Irrigation <input type="checkbox"/> Air conditioning <input type="checkbox"/> Commercial <input type="checkbox"/> Test well <input type="checkbox"/> Oil well	
		Surface		0	2	7 Casing: Material <b>PVC</b> Height: above/below Threaded <input type="checkbox"/> Welded <input type="checkbox"/> Surface <b>18</b> in. Diam. <b>5 1/2</b> in. to <b>110</b> ft. depth Drive shoe? <input type="checkbox"/> Yes <input type="checkbox"/> No <b>5 1/2</b> in. to <b>260</b> ft. depth	
		Sandy Clay		2	17	8 Screen: Manufacturer <b>Wesco</b> Type _____ Dia. _____ Slot/gauze <b>.030</b> Length _____ Set between <b>200</b> ft. and <b>210</b> ft. Fittings: <b>1/8 to 3/16</b> Gravel pack <input checked="" type="checkbox"/> Yes <input type="checkbox"/> No Size range of material _____	
		Fine Sand		17	25	9 Static water level: <b>110</b> ft. below land surface Date <b>4/15/75</b>	
		Sandy Clay		25	40	10 Pumping level below land surfaces: _____ ft. after _____ hrs. pumping _____ g.p.m. _____ ft. after _____ hrs. pumping _____ g.p.m. Estimated maximum yield <b>50</b> g.p.m.	
		Coarse Sand & Clay 60/40		40	60	11 Water sample submitted: <input type="checkbox"/> Yes <input checked="" type="checkbox"/> No Date _____	
		Fine Sand & Clay 90/10		60	125	12 Well head completion: <input type="checkbox"/> Pitless adapter <b>18</b> inches above grade	
		Sandstone		125	260	13 Well grouted? <input checked="" type="checkbox"/> Yes <input type="checkbox"/> No <input checked="" type="checkbox"/> Neat cement <input type="checkbox"/> Bentonite <input type="checkbox"/> _____ Depth: From <b>0</b> ft. to <b>10</b> ft.	
		Capped in Plastic Cap: Well given to Forrest Service Cimarron National Grassland Elkhart, KS 67950 6/2/75 6/4/75 DUB				14 Nearest source of possible contamination: ft. <b>100</b> Direction <b>SW</b> Type <b>Oil</b> Well Well disinfected upon completion? <input checked="" type="checkbox"/> Yes <input type="checkbox"/> No	
						15 Pump: <input checked="" type="checkbox"/> Not installed Manufacturer's name _____ Model number _____ HP _____ Volts _____ Length of drop pipe _____ ft. capacity _____ g.m.p. Type: <input type="checkbox"/> Submersible <input type="checkbox"/> Turbine <input type="checkbox"/> Jet <input type="checkbox"/> Reciprocating <input type="checkbox"/> Centrifugal <input type="checkbox"/> Other	
16 Remarks: elevation						17 Water well contractor's certification: This well was drilled under my jurisdiction and this report is true to the best of my knowledge and belief. <b>Carlile Water Well 118</b> Business name <b>Box 275, Liberal, KS.</b> License No. <b>67901</b> Address <b>Edward G. Means</b> Date <b>4/24/75</b> Signed _____ Authorized representative	