

USE TYPEWRITER OR BALL  
POINT PEN-PRESS FIRMLY,  
PRINT CLEARLY.

WATER WELL RECORD  
KSA 82a-1201-1215

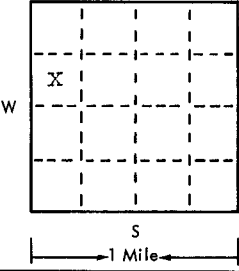
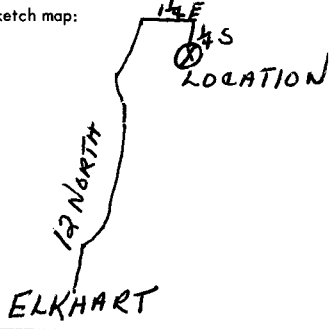
T R EW sec 1/4 1/4 1/4 No.

Kansas State Dept. Of Health  
(Water Well Contractors)  
Forbes-Bldg. 740  
Topeka, Kansas 66620

Boehm *LP6*

CWW Inv. #11171

*Storage Well # 29*

1 Location of well:	County <b>Morton</b>	Township name	Fraction <b>SW-NW</b>	Section number <b>15</b>	Town number <b>33S</b>	Range number <b>42W</b>	
Distance and direction from nearest town or city: <b>12 miles north, 1 1/2 miles east, 1/4 North of Elkhart</b>				3 Owner of well: <b>Sterling Drilling Company</b> Address: <b>Box 129 Sterling, Kansas 67579</b>			
Locate with "X" in section below: 		Sketch map: 		4 Well depth: <b>240</b> ft. Date of completion <b>3-28-75</b> Well diameter <b>9</b> in.			
2		Type and color of material		From	To	5 <input type="checkbox"/> Cable tool <input checked="" type="checkbox"/> Rotary <input type="checkbox"/> Driven <input type="checkbox"/> Dug <input type="checkbox"/> Hollow rod <input type="checkbox"/> Jetted <input type="checkbox"/> Bored <input type="checkbox"/> Reverse rotary	
		Surface		0	2	6 Use: <input type="checkbox"/> Domestic <input type="checkbox"/> Public supply <input checked="" type="checkbox"/> Industry <input type="checkbox"/> Irrigation <input type="checkbox"/> Air conditioning <input type="checkbox"/> Commercial <input type="checkbox"/> Test well <input type="checkbox"/> <b>Oil Rig</b>	
		Clay		2	20	7 Casing: Material <b>PVC</b> Height: above/below Threaded <input type="checkbox"/> Welded <input type="checkbox"/> Surface <b>18</b> in. Diam. <b>2.78</b> lbs./ft. <b>5</b> in. to <b>110</b> ft. depth Drive shoe? <input type="checkbox"/> Yes <input checked="" type="checkbox"/> No <b>5</b> in. to <b>240</b> ft. depth	
		Sandy Clay		20	58	8 Screen: Manufacturer <b>WESCO</b> Type <b>PVC</b> Dia. <b>5</b> Slot/gauze <b>.030</b> Length <b>10'</b> Set between <b>190</b> ft. and <b>200</b> ft. Fittings: <b>1/8 - 3/16</b> Gravel pack <input checked="" type="checkbox"/> Yes <input type="checkbox"/> No Size range of material	
		Med. to Lg. Sand W/clay 80-20		58	100	9 Static water level: <b>90</b> ft. below land surface Date <b>3-28-75</b>	
		Med. to Lg. Sand W/clay 60-40		100	120	10 Pumping level below land surfaces: ____ ft. after ____ hrs. pumping ____ g.p.m. ____ ft. after ____ hrs. pumping ____ g.p.m. Estimated maximum yield <b>40</b> g.p.m.	
		Med. to Lg. Sand W/clay 70-30		120	160	11 Water sample submitted: <input type="checkbox"/> Yes <input checked="" type="checkbox"/> No Date	
		Med. to Lg. Sand W/clay 80-20		160	200	12 Well head completion: <input type="checkbox"/> Pitless adapter <input checked="" type="checkbox"/> <b>18</b> inches above grade	
		Med. to Lg. Sand & Sandstone 70-30		200	220	13 Well grouted? <input checked="" type="checkbox"/> Yes <input type="checkbox"/> No <input checked="" type="checkbox"/> Neat cement <input checked="" type="checkbox"/> Bentonite <input type="checkbox"/> Depth: From <b>60</b> ft. to <b>240</b> ft.	
		Med. to Lg. Sand & Redbed 50-50		220	240	14 Nearest source of possible contamination: ft. <b>100</b> Direction <b>ne</b> Type <b>Oil well</b> Well disinfected upon completion? <input checked="" type="checkbox"/> Yes <input type="checkbox"/> No	
		<i>Well Give to Forrest Service, Cimarron National Grassland Elkhart, Kansas 67950</i>				15 Pump: <input checked="" type="checkbox"/> Not installed Manufacturer's name Model number HP Volts Length of drop pipe ft. capacity g.m.p. Type: <input type="checkbox"/> Submersible <input type="checkbox"/> Turbine <input type="checkbox"/> Jet <input type="checkbox"/> Reciprocating <input type="checkbox"/> Centrifugal <input type="checkbox"/> Other	
		<i>Written com. on 4/25/75 4/29/75 DWB</i>				16 Remarks: elevation	
		<i>(use a second sheet if needed)</i>				17 Water well contractor's certification: This well was drilled under my jurisdiction and this report is true to the best of my knowledge and belief. <b>Carlilo Water Well 118</b> Business name License No. Address <b>Box 275, Liberal, Kansas</b> Signed <b>Edward E. Means</b> Date <b>3-31-75</b> Authorized representative	