


1 LOCATION OF WATER WELL: County: Morton Co Fraction: NE 1/4 NE 1/4 Section Number: 18 Township Number: T33 Range Number: 43 E/W: (W)

Distance and direction from nearest town or city street address of well if located within city?
15 mi NW of Elkhead

2 WATER WELL OWNER: Colorado Interstate Gas
 RR#, St. Address, Box #: 3060 N Briargate
 City, State ZIP Code: Colorado Springs CO 80910

Global Positioning Systems (decimal degrees, min. of 4 digits)
 Latitude: 37° 18' 33" N
 Longitude: 102° 01' 52" W
 Elevation: 3650
 Datum: N 00° 39' 00" E
 Data Collection Method: IC # LS-1097

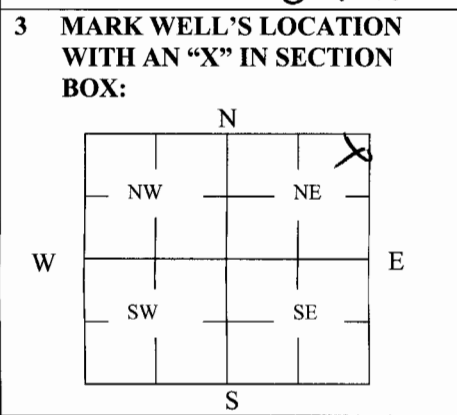

4 DEPTH OF WELL 70.4 ft.
 WELL'S STATIC WATER LEVEL 70.36 ft. MW-1

WELL WAS USED AS:

1 Domestic	5 Public Water Supply	9 Dewatering
2 Irrigation	6 Oil Field Water Supply	<input checked="" type="radio"/> 10 Monitoring
3 Feedlot	7 Domestic (Lawn & Garden)	11 Injection Well
4 Industrial	8 Air Conditioning	12 Other _____

Was a chemical/bacteriological sample submitted to Department? Yes _____ No

5 TYPE OF BLANK CASING USED:

1 Steel	3 RMP (SR)	5 Wrought	7 Fiberglass	9 Other (Specify below)
<input checked="" type="radio"/> 2 PVC	4 ABS	6 Asbestos-Cement	8 Concrete Tile	

Blank casing diameter 4 in. Was casing pulled? Yes No _____ If yes, how much all (drilled out)
 Casing height above or below land surface N/A in.

6 GROUT PLUG MATERIAL: 1 Neat cement 2 Cement grout 3 Bentonite 4 Other _____

Grout Plug Intervals: From 0 ft. to 70.4 ft., From _____ ft. to _____ ft., From _____ to _____ ft.

What is the nearest source of possible contamination:

1 Septic tank	6 Seepage pit	<input checked="" type="radio"/> 11 Fuel Storage	16 Other (specify below)
2 Sewer lines	7 Pit privy	12 Fertilizer storage	
3 Watertight sewer lines	8 Sewage lagoon	13 Insecticide storage	
4 Lateral lines	9 Feedyard	14 Abandoned water well	
5 Cess pool	10 Livestock pens	15 Oil well/Gas well	

Direction from well? Surrounding area
 How many feet? Surrounding area
compressor pump station

FROM	TO	PLUGGING MATERIALS	FROM	TO	PLUGGING MATERIALS
<u>0</u>	<u>70.4</u>	<u>cement grout</u>			

7 CONTRACTOR'S OR LANDOWNER'S CERTIFICATION: This water well was plugged under my jurisdiction and was completed on (mo/day/year) 9-6-06 and this record is true to the best of my knowledge and belief. Kansas Water Well Contractor's License No. 703. This Water Well Record was completed on (mo/day/year) 9-25-06 under the business name of Peterson Drilling, Testing by (signature) [Signature]

INSTRUCTIONS: Use typewriter or ballpoint pen. Please press firmly and print clearly. Please fill in blanks, underline or circle the correct answers. Send top three copies to Kansas Department of Health and Environment, Bureau of Water, Geology Section, 1000 SW Jackson St., Ste. 420, Topeka, Kansas 66612-1367. Telephone: 785/296-5522. Send one to Water Well Owner and retain one for your records. Visit us at <http://www.kdheks.gov/geo/waterwells>.