


WATER WELL RECORD Form WWC-5 KSA 82a-1212

1 LOCATION OF WATER WELL: Fraction Section Number Township Number Range Number
 COUNTY: MORTON SE 1/4 NW 1/4 SE 1/4 6 T 33 S R 43 W

Distance and direction from nearest town or city street address of well if located within city?
 ELKHART-N ON 27, 10 W TO JCT 27 & 51, W ON 51, 7N ON RD.

2 WATER WELL OWNER: CIMARRON NATIONAL GRASS L
 RR#, St. Address, Box #: PO BOX 300 Board of Agriculture, Division of Water Resources
 City, State, ZIP code: ELKHART, KS 67950- Application Number:

3 LOCATE WELL'S LOCATION WITH AN "X" IN SECTION BOX:

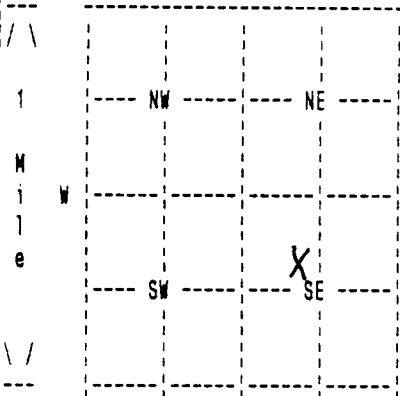

4 DEPTH OF COMPLETED WELL 325 ELEVATION: 0
 Depth(s) Groundwater Encountered 1. 0 ft. 2. 0 ft. 3. 0 ft.

WELL'S STATIC WATER LEVEL 131 ft. below land surface measured on mo/day/yr 07/31/07
 Pump testdata: Well water was 0 ft. after 0 hours pumping 0 gpm

Estimated Yield 45 gpm: Well water was 0 ft. after 0 hours pumping 0 gpm

Bore Hole Diameter 9 in. to 325 ft., and in. to 0 ft.

WELL WATER TO BE USED AS: DOMESTIC

Was a chemical/bacteriological sample submitted to department? No ;
 If yes, mo/day/yr sample was submitted Water well disinfected? Yes

5 TYPE OF BLANK CASING USED: CERTA LOC CASIN CASING JOINTS: CERTA-LOC
 Blank casing diameter 5 in. to 325 ft., Dia in. to 0 ft., Dia in. to 0 ft.
 Casing height above land surface 12 in., weight 200 lbs/ft. Wall thickness or gauge No. 21
 TYPE OF SCREEN OR PERFORATION MATERIAL: PVC
 SCREEN OR PERFORATION OPENINGS ARE: SAW CUT

SCREEN PERFORATED INTERVALS: From 280 ft. to 320 ft., From 0 ft. to 0 ft.
 From 0 ft. to 0 ft., From 0 ft. to 0 ft.
 GRAVEL PACK INTERVALS: From 25 ft. to 325 ft., From 0 ft. to 0 ft.
 From 0 ft. to 0 ft., From 0 ft. to 0 ft.

6 GROUT MATERIAL BENTONITE
 Grout Intervals: From 0 ft. to 25 ft., From 0 ft. to 0 ft., From 0 ft. to 0 ft.
 What is the nearest source of possible contamination: ABANDONED WELL
 Direction from well? NORTHWEST How many feet? 25

FROM	TO	LITHOLOGIC LOG	FROM	TO	PLUGGING INTERVALS
0	20	01 TOPSOIL 02 FINE SAND			
20	40	02 FINE SAND 32 TAN CLAY			
40	60	05 CLAY 10 FINE-MEDSAND			
60	80	02 FINE SAND			
80	100	10 FINE-MEDSAND 32 TAN CLAY			
100	120	32 TAN CLAY 35 CALACHIE			
120	140	10 FINE-MEDSAND			
140	160	10 FINE-MEDSAND 20 RED SHALE			
160	180	20 RED SHALE 29 SANDSTONE			
180	315	29 SANDSTONE			

7 CONTRACTOR'S OR LANDOWNER'S CERTIFICATION: This water well was Constructed under my jurisdiction and was completed on (mo/day/year) 07/31/07 and this record is true to the best of my knowledge and belief. Kansas Water Well Contractor's License No. 179 This Water Well Record was completed on (mo/day/yr) 08/07/07 under the business name of JOE'S WELL SERVICE, INC. by (signature) *Jessie Creek*

(Continued)

WATER WELL RECORD Form WWC-5 KSA 82a-1212

1 LOCATION OF WATER WELL:	Fraction	Section Number	Township Number	Range Number
COUNTY: MORTON	SE 1/4 NW 1/4 SE 1/4	6	T 33 S	R 43 W

2 WATER WELL OWNER: CIMARRON NATIONAL GRASS L
RR#, St. Address, Box #: PO BOX 300
City, State, ZIP code: ELKHART, KS 67950-
Board of Agriculture, Division of Water Resources
Application Number:

FROM	TO	LITHOLOGIC LOG
315	330	20 RED SHALE

7 CONTRACTOR'S OR LANDOWNER'S CERTIFICATION: This water well was Constructed under my jurisdiction and was completed on (mo/day/year) 07/31/07 and this record is true to the best of my knowledge and belief. Kansas Water Well Contractor's License No. 179 This Water Well Record was completed on (mo/day/yr) 08/07/07 under the business name of JOE'S WELL SERVICE, INC. by (signature) *Judith Creek*