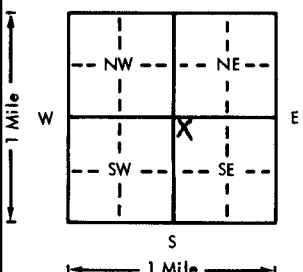


USE TYPEWRITER OR BALL
POINT PEN-PRESS FIRMLY,
PRINT CLEARLY.

WATER WELL RECORD
KSA 82a-1201-1215

Kansas Department of Health and
Environment-Division of Environment
(Water well Contractors)
Topeka, Kansas 66620

| | | | | | | |
|--|--|---|---|---|------------------------------|-----------------------------|
| 1. Location of well: | | County Monto IV | Fraction NW 1/4 NW 1/4 SE 1/4 | Section number 3 | Township number 33 | Range number 43 E |
| 2. Distance and direction from nearest town or city: 13N 3W 1/2N 1/2W | | | | 3. Owner of well: Phentice Soupsiet | | |
| Street address of well location if in city: EIKHANT-KANS | | | | R.R. or street: City, state, zip code: EIKHANT-KANS 67950 | | |
| 4. Locate with "X" in section below: | | Sketch map: | | 6. Bore hole dia. 3 1/2 in. Completion date 3-15-76 Well depth 340 ft. | | |
|  | | | | 7. <input checked="" type="checkbox"/> Cable tool <input checked="" type="checkbox"/> Rotary <input type="checkbox"/> Driven <input type="checkbox"/> Dug <input type="checkbox"/> Hollow rod <input type="checkbox"/> Jetted <input type="checkbox"/> Bored <input type="checkbox"/> Reverse rotary | | |
| 5. Type and color of material | | | | From | To | |
| Top soil | | | | 0 | 35 | |
| Clay & Gyp rock | | | | 35 | 55 | |
| Clay Brown | | | | 55 | 70 | |
| SAND Coarse | | | | 70 | 100 | |
| SAND & Clay str's Brown | | | | 100 | 115 | |
| SAND Rock TAN & Brown | | | | 115 | 130 | |
| Clay Red & Green | | | | 130 | 145 | |
| SAND Rock TAN & Silty | | | | 145 | 153 | |
| SAND Rock TAN using water | | | | 153 | 170 | |
| SAND Rock yellow & TAN Clean | | | | 170 | 205 | |
| SAND Rock TAN Clean L.C. 2.50-260 | | | | 205 | 280 | |
| SAND Rock Red & Clay str's Red | | | | 280 | 300 | |
| SAND Rock TAN & Red Clean | | | | 300 | 340 | |
| (Use a second sheet if needed) | | | | | | |
| 18. Elevation: | | 19. Remarks: | | 20. Water well contractor's certification: | | |
| Topography: <input checked="" type="checkbox"/> Hill <input checked="" type="checkbox"/> Slope <input type="checkbox"/> Upland <input type="checkbox"/> Valley | | Concrete Slab to be installed By Customer Ronald Soupsiet | | This well was drilled under my jurisdiction and this report is true to the best of my knowledge and belief. Ralph's Innigation Drilling Contr Business name Address Springfield, Mo 65703 License No. 154 Signed Ralph R. Woods Date 3-15-76 Authorized representative | | |