USE TYPEWRITER OR BALL POINT PEN-PRESS FIRMLY, PRINT CLEARLY.

T R EW sec 1/4 1/4 1/4 No.

WATER WELL RECORD
KSA 82a-1201-1215

Kansas State Dept. Of Health
(Water Well Contractors)
Forbes-Bldg. 740
Topeka, Kansas 66620

1 Location of well:	County	Township name	Fraction	Section number	Town number	Range number
	MORTON	WESTOLA	NWSE1/4	3 R.W.	33	43

Distance and direction from nearest town or city: 13N 3W 1½N ½W ELKHART-KANS. 67950
Street address of well location if in city:

3 Owner of well: PRENTICE SOUPISET
Address: ELKHART-KANS. 67950

Locate with "X" in section below: Sketch map:

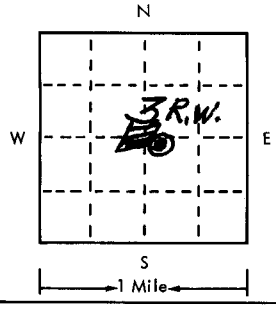

4 Well depth: 340 ft. Date of completion 10-20-75
Well diameter 19 in.

5 ☐ Cable tool ☒ Rotary ☐ Driven ☐ Dug ☐ Hollow rod ☐ Jetted ☐ Bored ☐ Reverse rotary

6 Use: ☐ Domestic ☐ Public supply ☐ Industry ☒ Irrigation ☐ Air conditioning ☐ Commercial ☐ Test well ☐ _____

7 Casing: Material 21⅞ Height: (above) ~~below~~
Threaded ☐ Welded ☒ Surface 18 in.
Diam. Weight _____ lbs./ft.
16 in. to 145 ft. depth Drive shoe? ☐ Yes ☒ No
14 in. to 340 ft. depth

2 Type and color of material	From	To
Top Soil & Clay Gyp	0	35
Gyp Rock & Clay	35	55
Clay & Sandy Clay	55	70
Coarse SAND & Clay Stks	70	100
SAND & Clay Stks	100	115
TAN S.R. & Brown Rock Stks	115	130
Red Clay & Green Clay stks	130	145
Silty S.R. & Clay	145	153
TAN S.R. Clean Drilling Good Usable Water	153	170
yel.-TAN S.R. Clean	170	205
TAN S.R. Clean L.C. 250-260	205	280
Red S.R. Red Clay Stks	280	300
Red-TAN S.R. Drilled Good & Clean	300	340
(use a second sheet if needed)		

8 Screen:
Manufacturer _____
Type _____ Dia. _____
Slot/gauze ¼" Cut Length 75
Set between 75 ft. and 145 ft. 340
Fittings:
Gravel pack ☐ Yes ☒ No Size range of material _____

9 Static water level:
81 ft. below land surface Date 10-20-75

10 Pumping level below land surfaces:
180 ft. after 12 hrs. pumping 1100 g.p.m.
_____ ft. after _____ hrs. pumping _____ g.p.m.
Estimated maximum yield 1100 g.p.m.

11 Water sample submitted:
☐ Yes ☒ No Date _____

12 Well head completion:
☐ Pitless adapter ☐ Inches above grade

13 Well grouted? ☐ Yes ☒ No
☐ Neat cement ☐ Bentonite ☒ Concrete
Depth: From 1½ Above 10 ft. Below Ground

14 Nearest source of possible contamination: NONE
ft. _____ Direction _____ Type _____
Well disinfected upon completion? ☐ Yes ☐ No

15 Pump: ☒ Not installed
Manufacturer's name _____
Model number _____ HP _____ Volts _____
Length of drop pipe _____ ft. capacity _____ g.m.p.
Type:
☐ Submersible ☐ Turbine
☐ Jet ☐ Reciprocating
☐ Centrifugal ☐ Other

16 Remarks: elevation

Topography:
☐ Hill
☐ Slope
☒ Upland
☐ Valley

17 Water well contractor's certification:
This well was drilled under my jurisdiction and this report is true to the best of my knowledge and belief.
Ralph's Irrigation & Drilling Contr
Business name License No.
Address 1209 S. MAIN 1544
Signed Ralph E. Woods Date _____
Authorized representative
Springfield Colo. 81073

Forward the white, blue and pink copies to the Kansas State Dept. Of Health.

Form WWC-5

33 43W 3 NW NW SE