USE TYPEWRITER OR BALL POINT PEN-PRESS FIRMLY, PRINT CLEARLY.

WATER WELL RECORD
KSA 82a-1201-1215

Kansas Department of Health and Environment-Division of Environment
(Water well Contractors)
Topeka, Kansas 66620

1. Location of well:	County	Fraction	Section number	Township number	Range number
	Morton	NW 1/4 SW 1/4 SW 1/4	11	T 33 S	R 43 E/W

2. Distance and direction from nearest town or city: 12 N. 4 W 1/4 N of Elkhart, KS.
Street address of well location if in city:

3. Owner of well: U.S. Forest Service
R.R. or street:
City, state, zip code: Elkhart, KS. 67950

4. Locate with "X" in section below: Sketch map:

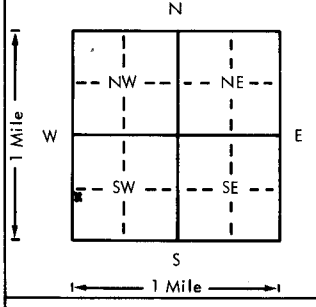

6. Bore hole dia. 9 in. Completion date 6/14/78
Well depth 120 ft.

7. __ Cable tool X Rotary __ Driven __ Dug
__ Hollow rod __ Jetted __ Bored __ Reverse rotary

8. Use: __ Domestic __ Public supply __ Industry
__ Irrigation __ Air conditioning X Stock
__ Lawn __ Oil field water __ Other

9. Casing: Material PVC Height: Above or below
Threaded __ Welded __ Surface 18 in.
RMP __ PVC X Weight __ lbs./ft.
Dia. 5 in. to 80 ft. depth Wall Thickness: inches or
Dia. __ in. to __ ft. depth gage No. 0.258

5. Type and color of material	From	To
Overburden	0	70
Clay	70	95
Medium Sand + Clay Streaks	95	115
Clay	115	120

(Use a second sheet if needed)

10. Screen: Manufacturer's name Peerless Plastics
Type PVC Dia. 5"
Slot/gauze 1/16 Length 40
Set between 80 ft. and 120 ft.
ft. and ft.
Gravel pack? Yes Size range of material 4P

11. Static water level: mo./day/yr.
70 ft. below land surface Date 6/14/78

12. Pumping level below land surfaces:
ft. after hrs. pumping g.p.m.
ft. after hrs. pumping g.p.m.
Estimated maximum yield 45 g.p.m.

13. Water sample submitted: mo./day/yr.
__ Yes X No Date

14. Well head completion:
__ Pitless adapter 18 Inches above grade

15. Well grouted? Yes
With: X Neat cement __ Bentonite __ Concrete
Depth: From 3 ft. to 13 ft.

16. Nearest source of possible contamination: None
ft. Direction Type
Well disinfected upon completion? X Yes __ No

17. Pump: X Not installed
Manufacturer's name
Model number HP Volts
Length of drop pipe ft. capacity g.p.m.
Type:
__ Submersible __ Turbine
__ Jet __ Reciprocating
__ Centrifugal __ Other

18. Elevation:
Topography:
__ Hill
__ Slope
X Upland
__ Valley

19. Remarks: Pasteur Well
Pasteur #9
Well to be completed at a later date.

20. Water well contractor's certification:
This well was drilled under my jurisdiction and this report is true to the best of my knowledge and belief.
T & W Water Well 142
Business name License No.
Address Box 816 Liberal KS
Signed [signature] Date 6/7/78
Authorized representative

T 33 R 43 E W Sec 11 1/4 NW 1/4 SW 1/4

Forward the white, blue and pink copies to the Department of Health and Environment

Form WWC-5