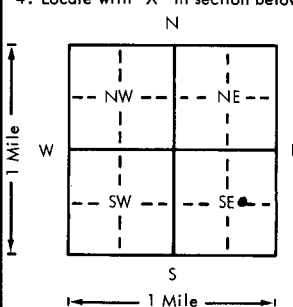


USE TYPEWRITER OR BALL POINT PEN-PRESS FIRMLY, PRINT CLEARLY.

WATER WELL RECORD
KSA 82a-1201-1215

Kansas Department of Health and Environment-Division of Environment
(Water well Contractors)
Topeka, Kansas 66620

1. Location of well: County MORTON		Fraction SW 1/4 NE 1/4 SE 1/4		Section number 24		Township number T 33 S R 43 E (N)		Range number	
2. Distance and direction from nearest town or city: 10 miles NORTH - 2 1/4 miles West 1/4 mile NORTH of Elkhart				3. Owner of well: Cities Service Oil Co. R.R. or street: 509 S. Cosmos City, state, zip code: Elkhart, Kansas 67950					
4. Locate with "X" in section below: 				Sketch map:		6. Bore hole dia. 9 in. Completion date 12-14-78 Well depth 240 ft.			
						7. <input checked="" type="checkbox"/> Cable tool <input checked="" type="checkbox"/> Rotary <input type="checkbox"/> Driven <input type="checkbox"/> Dug <input type="checkbox"/> Hollow rod <input type="checkbox"/> Jetted <input type="checkbox"/> Bored <input type="checkbox"/> Reverse rotary			
						8. Use: <input type="checkbox"/> Domestic <input type="checkbox"/> Public supply <input type="checkbox"/> Industry <input type="checkbox"/> Irrigation <input type="checkbox"/> Air conditioning <input type="checkbox"/> Stock <input type="checkbox"/> Lawn <input checked="" type="checkbox"/> Oil field water <input type="checkbox"/> Other			
						9. Casing: Material PVC Height: Above or below Threaded <input type="checkbox"/> Welded <input checked="" type="checkbox"/> Surface 20 in. RMP <input type="checkbox"/> PVC <input checked="" type="checkbox"/> Weight 300 lbs./ft. Dia. 5 in. to 100 ft. depth Wall Thickness: inches or Dia. <input type="checkbox"/> in. to <input type="checkbox"/> ft. depth Igage No. 0.258			
5. Type and color of material				From	To	10. Screen: Manufacturer's name Peerless Plastic Type PVC Dia. <input type="checkbox"/> Slot/gauze 1/16 Length 140' Set between 100 ft. and 240 ft. <input type="checkbox"/> ft. and <input type="checkbox"/> ft. Gravel pack? <input checked="" type="checkbox"/> Yes Size range of material 1/8			
Overburden				0	105'	11. Static water level: <input type="checkbox"/> mo./day/yr. 105 ft. below land surface Date 12-14-78			
Sandstone + Clay				105'	230'	12. Pumping level below land surfaces: 110 ft. after 1 hrs. pumping 50 g.p.m. <input type="checkbox"/> ft. after <input type="checkbox"/> hrs. pumping <input type="checkbox"/> g.p.m. Estimated maximum yield 80 g.p.m.			
Red Bed				230'		13. Water sample submitted: <input type="checkbox"/> mo./day/yr. <input type="checkbox"/> Yes <input checked="" type="checkbox"/> No Date <input type="checkbox"/>			
						14. Well head completion: <input type="checkbox"/> Pitless adapter 20 Inches above grade			
						15. Well grouted? <input checked="" type="checkbox"/> Yes With: <input checked="" type="checkbox"/> Neat cement <input type="checkbox"/> Bentonite <input type="checkbox"/> Concrete Depth: From 0 ft. to 10 ft.			
						16. Nearest source of possible contamination: NONE ft. <input type="checkbox"/> Direction <input type="checkbox"/> Type <input type="checkbox"/> Well disinfected upon completion? <input checked="" type="checkbox"/> Yes <input type="checkbox"/> No			
						17. Pump: <input type="checkbox"/> Not installed Manufacturer's name GOULD Model number <input type="checkbox"/> HP 5 Volts 230 Length of drop pipe 230 ft. capacity 50 g.p.m. Type: <input checked="" type="checkbox"/> Submersible <input type="checkbox"/> Turbine <input type="checkbox"/> Jet <input type="checkbox"/> Reciprocating <input type="checkbox"/> Centrifugal <input type="checkbox"/> Other			
						20. Water well contractor's certification: This well was drilled under my jurisdiction and this report is true to the best of my knowledge and belief. FW Water Well Service Inc 142 Business name Box 816 Liberal Ks 67401 License No. <input type="checkbox"/> Address CD Waggoner Date 12/14/78 Signed <input type="checkbox"/> Authorized representative			
18. Elevation:		19. Remarks:		(Use a second sheet if needed)					
Topography: <input type="checkbox"/> Hill <input type="checkbox"/> Slope <input checked="" type="checkbox"/> Upland <input type="checkbox"/> Valley									

T
33
R
43
E
24
Sec
SW NE SE
1/4 1/4 1/4