


1 LOCATION OF WATER WELL: Fraction SW 1/4 SW 1/4 SW 1/4 Section Number 20 Township Number T 33S S Range Number R 7W 34W
 County: Harper Distance and direction from nearest town or city street address of well if located within city?
 3 MILES WEST of Anthony, Kans.

2 WATER WELL OWNER: MORRISON & CO., INC.
 RR#, St. Address, Box #: Box 564 Board of Agriculture, Division of Water Resources
 City, State, ZIP Code: Anthony, Kans. 67003 Application Number:

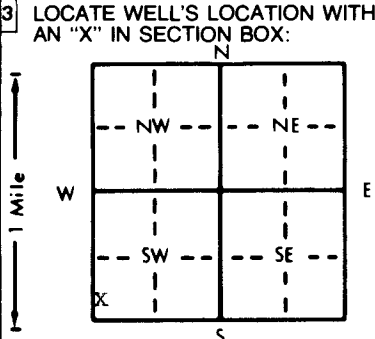

4 DEPTH OF COMPLETED WELL: 80' ft. ELEVATION: ...
 Depth(s) Groundwater Encountered 1. 15' ft. 2. ... ft. 3. ... ft.
 WELL'S STATIC WATER LEVEL: 15' ft. below land surface measured on mo/day/yr Oct. 29-93
 Pump test data: Well water was NA ft. after ... hours pumping ... gpm
 Est. Yield 15 gpm: Well water was ... ft. after ... hours pumping ... gpm
 Bore Hole Diameter: 7 7/8" in. to 20' - 6" ft., and 6 3/4" in. to 80' ft.
 WELL WATER TO BE USED AS: 5 Public water supply 8 Air conditioning 11 Injection well
 1 Domestic 3 Feedlot 6 Oil field water supply 9 Dewatering 12 Other (Specify below)
 2 Irrigation XX4 Industrial 7 Lawn and garden only 10 Monitoring well
 Was a chemical/bacteriological sample submitted to Department? Yes ... No X ... If yes, mo/day/yr sample was submitted
 Water Well Disinfected? Yes X No

5 TYPE OF BLANK CASING USED:
 1 Steel 3 RMP (SR) 5 Wrought iron 8 Concrete tile CASING JOINTS: Glued X Clamped
 XX2 PVC 4 ABS 6 Asbestos-Cement 9 Other (specify below) Welded
 7 Fiberglass Threaded
 Blank casing diameter: 5" in. to 20' 6" ft., Dia ... in. to ... ft., Dia ... in. to ... ft.
 Casing height above land surface: 14" in., weight 160 lbs./ft. Wall thickness or gauge No. sdr. 26
 TYPE OF SCREEN OR PERFORATION MATERIAL:
 1 Steel 3 Stainless steel 5 Fiberglass 8 RMP (SR) 10 Asbestos-cement
 2 Brass 4 Galvanized steel 6 Concrete tile 9 ABS 11 Other (specify) XX
 12 None used (open hole) XX
 SCREEN OR PERFORATION OPENINGS ARE:
 1 Continuous slot 3 Mill slot 5 Gauzed wrapped 8 Saw cut 11 None (open hole)
 2 Louvered shutter 4 Key punched 6 Wire wrapped 9 Drilled holes
 7 Torch cut 10 Other (specify) NA
 SCREEN-PERFORATED INTERVALS: From NA ft. to NA ft., From ... ft. to ... ft.
 From ... ft. to ... ft., From ... ft. to ... ft.
 GRAVEL PACK INTERVALS: From NONE ft. to ... ft., From ... ft. to ... ft.
 From ... ft. to ... ft., From ... ft. to ... ft.

6 GROUT MATERIAL: 1 Neat cement 2 Cement grout XX Bentonite 4 Other
 Grout Intervals: From 20' 6" ft. to 3' ft., From ... ft. to ... ft., From ... ft. to ... ft.
 What is the nearest source of possible contamination:
 XX1 Septic tank 4 Lateral lines 7 Pit privy 10 Livestock pens ZZ4 Abandoned water well
 2 Sewer lines 5 Cess pool 8 Sewage lagoon 11 Fuel storage 15 Oil well/Gas well
 3 Watertight sewer lines 6 Seepage pit 9 Feedyard 12 Fertilizer storage 16 Other (specify below)
 13 Insecticide storage
 Direction from well? West How many feet? 125'

FROM	TO	LITHOLOGIC LOG	FROM	TO	PLUGGING INTERVALS
0'	13'	Top soil & red clay			
13'	15'	Red rock break			
15'	80'	Red rock w/ Broken intervals .			

7 CONTRACTOR'S OR LANDOWNER'S CERTIFICATION: This water well was (1) constructed, (2) reconstructed, or (3) plugged under my jurisdiction and was completed on (mo/day/year) Oct. 29, -93 and this record is true to the best of my knowledge and belief. Kansas Water Well Contractor's License No. 112 This Water Well Record was completed on (mo/day/yr) Nov. 19, 93 under the business name of Wells Drilling Co by (signature) Dal Wells

OFFICE USE ONLY
T
R
EW
SEC.
1/4
1/4
1/4