

Plugging Report
 Ship Number *34* S Range Number *10 W D*

LOCATION OF WATER WELL: Fraction *SE 1/4 NW 1/4 NW 1/4* Section Number *15*


City: *Baker* and direction from nearest town or city street address of well if located within city?
340 N. + 555 E. of Intersection Ave G + Main St. - Hazelton Ks.

WATER WELL OWNER: *Franklin Skaggs*

Board of Agriculture, Division of Water Resources
 Application Number:

St. Address, Box # :
 State, ZIP Code :

LOCATE WELL'S LOCATION WITH "X" IN SECTION BOX: DEPTH OF COMPLETED WELL: *11.0* ft. ELEVATION:

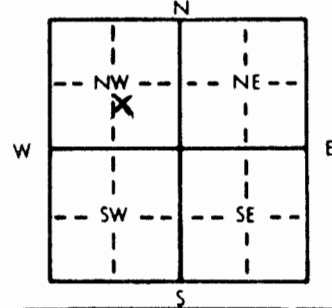

Depth(s) Groundwater Encountered 1. ft. 2. ft. 3. ft.
 WELL'S STATIC WATER LEVEL *6.0* ft. below land surface measured on mo/day/yr *3-11-88*
 Pump test data: Well water was ft. after hours pumping
 Est. Yield gpm: Well water was ft. after hours pumping
 Bore Hole Diameter in. to ft., and in. to
 WELL WATER TO BE USED AS:
 5 Public water supply 8 Air conditioning 11 Injection well
 1 Domestic 3 Feedlot 6 Oil field water supply 9 Dewatering 12 Other (Specify below)
 2 Irrigation 4 Industrial 7 Lawn and garden only 10 Observation well *Brick Cistern*
 Was a chemical/bacteriological sample submitted to Department? Yes No ; If yes, mo/day/yr sample was submitted
 Water Well Disinfected? Yes No

TYPE OF BLANK CASING USED:
 1 Steel 3 RMP (SR) 5 Wrought iron 8 Concrete tile CASING JOINTS: Glued Clamped
 2 PVC 4 ABS 6 Asbestos-Cement Other (specify below) *Brick* Welded
 7 Fiberglass Threaded

Blank casing diameter in. to ft., Dia in. to ft., Dia in. to
 Ring height above land surface in., weight lbs./ft. Wall thickness or gauge No.

TYPE OF SCREEN OR PERFORATION MATERIAL:
 1 Steel 3 Stainless steel 5 Fiberglass 7 PVC 10 Asbestos-cement
 2 Brass 4 Galvanized steel 6 Concrete tile 8 RMP (SR) Other (specify) *Brick*
 12 None used (open hole)

SCREEN OR PERFORATION OPENINGS ARE:
 1 Continuous slot 3 Mill slot 5 Gauzed wrapped 8 Saw cut 11 None (open hole)
 2 Louvered shutter 4 Key punched 6 Wire wrapped 9 Drilled holes
 7 Torch cut Other (specify) *spacing between brick*

SCREEN-PERFORATED INTERVALS: From ft. to ft., From ft. to ft.
 GRAVEL PACK INTERVALS: From ft. to ft., From ft. to ft.

ROUTING MATERIAL: Neat cement 2 Cement grout 3 Bentonite 4 Other
 Routing intervals: From *0.6* ft. to *5.5* ft., From ft. to ft., From ft. to ft.

What is the nearest source of possible contamination:
 1 Septic tank 4 Lateral lines 7 Pit privy 11 Fuel storage 15 Oil well/Gas well
 2 Sewer lines 5 Cess pool 8 Sewage lagoon 12 Fertilizer storage 16 Other (specify below)
 Watertight sewer lines 6 Seepage pit 9 Feedyard 13 Insecticide storage
 How many feet?

FROM	TO	LITHOLOGIC LOG	FROM	TO	LITHOLOGIC LOG
		<i>Top 5 removed, liquid pumped out, filled w/ chlorinated sand, 6" concrete cap poured + backfilled</i>			
		<i>Hazelton, Ks.</i>			

RECEIVED
 MAY - 3 1988

DIVISION OF ENVIRONMENT

CONTRACTOR'S OR LANDOWNER'S CERTIFICATION: This water well was (1) constructed, (2) reconstructed, or plugged under my jurisdiction and deleted on (mo/day/year) *3-11-88* and this record is true to the best of my knowledge and belief. Kar
 r Well Contractor's License No. This Water Well Record was completed on (mo/day/yr) *3-11-88*
 the business name of by (signature) *Steve May*

INSTRUCTIONS: Use typewriter or ball point pen. PLEASE PRESS FIRMLY and PRINT clearly. Please fill in blanks, underline or circle the correct answers. Send copies to Kansas Department of Health and Environment, Division of Environment, Environmental Geology Section, Topeka, KS 66620. Send one to WATER WELLER and retain one for your records.
 PW-18 #3 168