


WATER WELL RECORD Form WWC-5

Division of Water Resources App. No. [] Well ID MW-5

Original Record Correction Change in Well Use

1 LOCATION OF WATER WELL: County: Barber Fraction NW 1/4 NE 1/4 Section Number 16 Township Number T 34 S Range Number R 10 E W

2 WELL OWNER: Last Name: O.K. Cooperative Grain & Mercantile First: Address: P.O. Box 144 City: Kiowa State: KS ZIP: 67070 Street or Rural Address where well is located: 320 ft. east & 20 ft. south of intersection of Hwy K-2 & 1st Street Hazleton, KS.

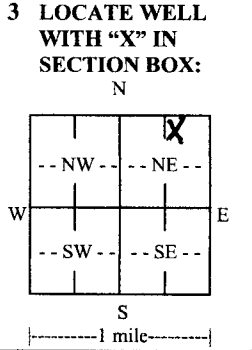

3 LOCATE WELL WITH 'X' IN SECTION BOX: 4 DEPTH OF COMPLETED WELL: 15 ft. Depth(s) Groundwater Encountered: 1) 10.5 ft. 2) 6-5-2020. 3) Dry Well. WELL'S STATIC WATER LEVEL: 10.5 ft. below land surface, measured on (mo-day-yr) 6-5-2020. Pump test data: Well water was ... ft. after ... hours pumping ... gpm. Estimated Yield: ... gpm. Bore Hole Diameter: 8.75 in. to 15 ft. and ... in. to ... ft.

5 Latitude: 37.03333 (decimal degrees) Longitude: -98.407222 (decimal degrees) Horizontal Datum: WGS 84 NAD 83 NAD 27 Source for Latitude/Longitude: GPS (unit make/model: (WAAS enabled? Yes No) Land Survey Topographic Map Online Mapper: Google Earth. 6 Elevation: NA ft. Ground Level TOC Source: Land Survey GPS Topographic Map Other

7 WELL WATER TO BE USED AS: 1. Domestic: Household Lawn & Garden Livestock Irrigation Feedlot Industrial. 2. Public Water Supply: well ID. 3. Dewatering: how many wells? 4. Aquifer Recharge: well ID. 5. Monitoring: well ID MW-5. 6. Environmental Remediation: well ID. 7. Air Sparge Soil Vapor Extraction Recovery Injection. 8. Oil Field Water Supply: lease. 9. Test Hole: well ID. Cased Uncased Geotechnical. 10. Geothermal: how many bores? a) Closed Loop Horizontal Vertical b) Open Loop Surface Discharge Inj. of Water. 11. Other (specify):

Was a chemical/bacteriological sample submitted to KDHE? Yes No If yes, date sample was submitted: Water well disinfected? Yes No

8 TYPE OF CASING USED: Steel PVC Other CASING JOINTS: Glued Clamped Welded Threaded. Casing diameter 2 in. to 5 ft. Diameter in. to ft. Casing height above land surface 36 in. Weight lbs./ft. Wall thickness or gauge No. sch 40. TYPE OF SCREEN OR PERFORATION MATERIAL: Steel Stainless Steel Fiberglass PVC Brass Galvanized Steel Concrete tile None used (open hole) Other (Specify). SCREEN OR PERFORATION OPENINGS ARE: Continuous Slot Mill Slot Gauze Wrapped Torch Cut Drilled Holes Other (Specify) Louvered Shutter Key Punched Wire Wrapped Saw Cut None (Open Hole). SCREEN-PERFORATED INTERVALS: From 5 ft. to 15 ft. GRAVEL PACK INTERVALS: From 3 ft. to 15 ft.

9 GROUT MATERIAL: Neat cement Cement grout Bentonite Other. Grout Intervals: From 0 ft. to 3 ft. Nearest source of possible contamination: Septic Tank Lateral Lines Pit Privy Livestock Pens Insecticide Storage Sewer Lines Cess Pool Sewage Lagoon Fuel Storage Abandoned Water Well Watertight Sewer Lines Seepage Pit Feedyard Fertilizer Storage Oil Well/Gas Well Other (Specify). Direction from well? Distance from well? ft.

Table with columns: 10 FROM, TO, LITHOLOGIC LOG, FROM, TO, LITHO. LOG (cont.) or PLUGGING INTERVALS. Rows: 0-5 Silty Clay, dark red brown, firm, moist; 5-9 Silty Clay, greenish gray, stiff, moist; 9-10 Silty Clay, greenish gray, saturated; 10-14 Sandy Clay, red, medium to coarse, saturated; 14-15 Shale, greenish gray, hard. Notes: []

11 CONTRACTOR'S OR LANDOWNER'S CERTIFICATION: This water well was constructed, reconstructed, or plugged under my jurisdiction and was completed on (mo-day-year) 6-3-2020 and this record is true to the best of my knowledge and belief. Kansas Water Well Contractor's License No. 694. This Water Well Record was completed on (mo-day-year) 6/30/2020 under the business name of Environmental Priority Service, Inc. Signature []